

STATE OF KANSAS
STATE CORPORATION COMMISSION

WELL PLUGGING RECORD

Give All Information Completely
Make Required Affidavit
Mail or Deliver Report to:
Conservation Division
State Corporation Commission
211 No. Broadway
Wichita, Kansas

Stafford County, Sec. 12 Twp. 25S Rge. 13 ~~XXXX~~ (W)

Location as "NE/CNW/SW" or footage from lines A/C SE/4 SW/4 SE/4

Lease Owner Barnett Oil Company

Lease Name Garey Well No. 1

Office Address 411 First Nat'l Bank Bldg., Wichita, Kansas

Character of Well (completed as Oil, Gas or Dry Hole) Dry Hole

Date well completed August 24, 19 58

Application for plugging filed August 25, 19 58

Application for plugging approved August 26, 19 58


Plugging commenced August 24, 19 58

Plugging completed August 24, 19 58

Reason for abandonment of well or producing formation _____

If a producing well is abandoned, date of last production _____ 19 _____

Was permission obtained from the Conservation Division or its agents before plugging was commenced? Yes

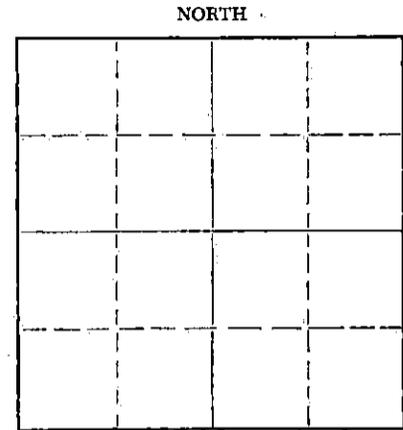

Locate well correctly on above
Section Plat

Name of Conservation Agent who supervised plugging of this well Frank Broadfoot

Producing formation _____ Depth to top _____ Bottom _____ Total Depth of Well 4183 Feet

Show depth and thickness of all water, oil and gas formations.

OIL, GAS OR WATER RECORDS

CASING RECORD

FORMATION	CONTENT	FROM	TO	SIZE	PUT IN	PULLED OUT
				8 5/8"	246'	-0-

Describe in detail the manner in which the well was plugged, indicating where the mud fluid was placed and the method or methods used in introducing it into the hole. If cement or other plugs were used, state the character of same and depth placed, from _____ feet to _____ feet for each plug set.

Filled hole to 240' with mud; set plug at 240' with 1/2 sack of hulls on top and 20 sacks of cement. Filled hole to 30'; set plug at 30' with 1/2 sack of hulls on top and 10 sacks of cement.

Plugged rat hole with 5 sacks of cement.

(Well Log attached)

RECEIVED
STATE CORPORATION COMMISSION

SEP 5 1958

CONSERVATION DIVISION
Wichita, Kansas

(If additional description is necessary, use BACK of this sheet)

Name of Plugging Contractor Barnett Drilling, Inc.
Address 409 First Nat'l Bank Bldg., Wichita, Kansas

STATE OF Kansas COUNTY OF Sedgwick, ss.

F. H. Rousey (employee of owner) ~~authorized operator~~ of the above-described well, being first duly sworn on oath, says: That I have knowledge of the facts, statements, and matters herein contained and the log of the above-described well as filed and that the same are true and correct. So help me God.

(Signature)

F. H. Rousey
411 First Nat'l Bank Bldg., Wichita, Kansas
(Address)

SUBSCRIBED AND SWORN TO before me this 4th day of September, 19 58

Mildred F. Willis
Notary Public.

My commission expires February 27, 1960.

PLUGGING
FILE SEC. 12 T. 25 R. 13W
BOOK PAGE 125 LINE 26

BARNETT OIL COMPANY
WELL LOG - GAREY NO. 1
A/C SE/4 SW/4 SE/4 of Section 12-25S-13W
STAFFORD COUNTY, KANSAS

Date Started: 8-11-58
Date Completed: 8-24-58

<u>From</u>	<u>To</u>	<u>Formation</u>
0	40	Surface
40	150	Sand
150	212	Red Bed
212	248	Blue Shale
248	875	Shale and shells
875	915	Sandy shale
915	1850	Shale and shells
1850	1960	Shale and lime
1960	2105	Lime
2105	2400	Lime and shale
2400	2560	Shale and shells
2560	2890	Shale
2890	3185	Shale and lime
3185	3260	Lime
3260	3390	Lime and shale
3390	3565	Lime
3565	3655	Lime and shale
3655	4183	Lime (T.D.) (D. & A.)

Set 246' of 8 5/8", 24# ss casing with
200 sacks of cement.

RECEIVED
STATE CORPORATION COMMISSION

SEP 5 1958

VISION

PLUGGING			
FILE	SEC	T	R
	12	25	13W
BOOK	PAGE	LINE	
	125	26	