


STATE OF KANSAS
STATE CORPORATION COMMISSION

WELL PLUGGING RECORD

Give All Information Completely
Make Required Affidavit
Mail or Deliver Report to
Conservation Division
State Corporation Comm.
245 North Water
Wichita, KS 67202

Stafford County. Sec. 12 Twp. 25S Rge. 13W
Location as "NE/CNW/SW" or footage from lines

C-N/2 SW SE
Lease Owner Mr. Robert L. Austin
Lease Name Garey Well No. 1
Office Address Box 159, Stafford, Kansas 67578
Character of Well (Completed as Oil, Gas or Dry Hole) Dry Hole

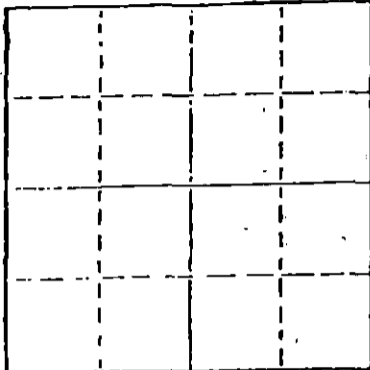

Locate well correctly on above
Section Plat

Date Well completed May 2, 1978
Application for plugging filed Verbal Application 19
Application for plugging approved Verbal Approval 19
Plugging commenced May 2, 1978
Plugging completed May 2, 1978
Reason for abandonment of well or producing formation

If a producing well is abandoned, date of last production 19

Was permission obtained from the Conservation Division or its agents before plugging was commenced? Yes

Name of Conservation Agent who supervised plugging of this well Wm. T. Owen
Producing formation _____ Depth to top _____ Bottom _____ Total Depth of Well 3,312
Show depth and thickness of all water, oil and gas formations.

OIL, GAS OR WATER RECORDS			CASING RECORD			
FORMATION	CONTENT	FROM	TO	SIZE	PUT IN	PULLED OUT
				8-5/8"	289'	None

Describe in detail the manner in which the well was plugged, indicating where the mud fluid was placed and the method or methods used in introducing it into the hold. If cement or other plugs were used, state the character of same and depth placed, from _____ feet to _____ feet for each plug set.

Filled hole with heavy rotary mud from 3,312 ft. (rotary total depth) to 540 ft. Set plug at 540 ft. and cemented with 40 sacks cement. Filled hole with heavy rotary mud from 540 ft. to 300 ft. Set plug at 300 ft. and cemented with 40 sacks cement. Filled hole with heavy rotary mud from 300 ft. to 40 ft. Set solid plug at 40 ft. and cemented to cellar with 12 sacks cement, 3 sacks cement in rat hole.

Plugging operations accomplished utilizing Allied Oil Well cementing pump truck through 4 1/2 inch drill pipe.

(If additional description is necessary, use BACK of this sheet)

Name of Plugging Contractor Allied Cementing Co., Inc.
Box 31, Russell, Kansas 67665

STATE OF Kansas COUNTY OF Sedgwick, ss.
Dean Britting, Agent (Employer of owner) or (owner or operator)

of the above-described well, being first duly sworn on oath, says: That I have knowledge of the facts, statements, and matters herein contained and the log of the above-described well as filed and that the same are true and correct. So help me God.

(Signature) Dean Britting
200 N. Main, Wichita, Kansas 67202
(Address)

SUBSCRIBED AND SWORN TO before me this 15th day of May, 1978



Elsie Willison
Elsie Willison - Notary Public.

My commission expires June 30, 1978

KANSAS DRILLERS LOG

COMPANY **Mr. Robert L. Austin**

SEC. 12 T. 25S R. 13W
LOC. C-N/2 SW SE

FARM **Garey**

NO. 1

COUNTY **Stafford**

ROTARY TOTAL DEPTH **3,312'**

COMM. **April 24, 1978**

COMP. **May 2, 1978**

CONTRACTOR **H-30, Inc.**

ISSUED **May 15, 1978**

CASING

10 3/4"

8 5/8" Set at 289' cemented w/250 sxs cement

5 1/2"

4 1/2"

ELEVATION

FIGURES INDICATE BOTTOM OF FORMATIONS

Sand

119'

Red Bed

471'

Shale and Red Bed

1,502'

Shale

1,630'

Shale and Lime

2,264'

Lime and Shale

3,312'

Rotary Total Depth

3,312'

RECEIVED
STATE CORPORATION COMMISSION

MAY 16 1978

CONSERVATION DIVISION
Wichita, Kansas

I hereby certify the above and foregoing to be a true and correct log of the above described well as shown by the drilling reports.

H-30, Inc.

Dean Britting
Dean Britting

State of Kansas }
County of Sedgwick } SS:

Suscribed and Sworn to before me a Notary Public in and for said county and state this 15th day of May, 1978.

Elsie Willison
Elsie Willison - Notary Public

My Commission Expires:

June 30, 1978

