

15-185-11642-0000

STATE OF KANSAS
STATE CORPORATION COMMISSION
Give All Information Completely
Make Required Affidavit
Mail or Deliver Report to:
Conservation Division
State Corporation Commission
800 Bitting Building
Wichita, Kansas


WELL PLUGGING RECORD

OR

FORMATION PLUGGING RECORD

Strike out upper line
when reporting plug-
ging off formations.

Stafford County. Sec. 12 Twp 25 Rge. (E) 13 (W)
Location as "NE $\frac{1}{4}$ NW $\frac{1}{4}$ SW $\frac{1}{4}$ " or footage from lines NE $\frac{1}{4}$ SE $\frac{1}{4}$ SW $\frac{1}{4}$
Lease Owner Musgrove Petroleum Corporation
Lease Name Fair Well No. 1
Office Address 407 K.F.H. Building, Wichita 2, Kansas
Character of Well (completed as Oil, Gas or Dry Hole) Dry Hole
Date well completed 11-16 1948
Application for plugging filed (Via Telephone) 11-16 1948
Application for plugging approved 11-16 1948
Plugging commenced 11-17 1948
Plugging completed 11-17 1948
Reason for abandonment of well or producing formation Dry Hole

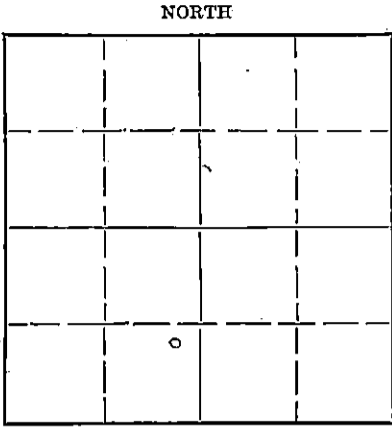

Locate well correctly on above
Section Plat

If a producing well is abandoned, date of last production 19
Was permission obtained from the Conservation Division or its agents before plugging was com-
menced? Agent

Name of Conservation Agent who supervised plugging of this well C. D. Stough
Producing formation Depth to top Bottom Total Depth of Well 4175 Feet
Show depth and thickness of all water, oil and gas formations.

OIL, GAS OR WATER RECORDS

CASING RECORD

Formation	Content	From	To	Size	Put In	Pulled Out

Describe in detail the manner in which the well was plugged, indicating where the mud fluid was placed and the method or methods used in introducing it into the hole. If cement or other plugs were used, state the character of same and depth placed, from feet to feet for each plug set.

Hole filled with heavy mud to 320'.
Set wooden plug.
Filled with 15 sacks of cement.
Ran another wooden plug.
Filled with 10 sacks of cement to surface.

RECEIVED

11-20-48
NOV 20 1948

STATE CORPORATION
COMMISSION

(If additional description is necessary, use BACK of this sheet)
Correspondence regarding this well should be addressed to Musgrove Petroleum Corporation
Address 407 K.F.H. Building
Wichita 2, Kansas

STATE OF KANSAS, COUNTY OF SEDGWICK, ss.
P. C. Musgrove (owner or operator) of the above-described well,
being first duly sworn on oath, says: That I have knowledge of the facts, statements, and matters herein contained and the log of the above-described well as filed and that the same are true and correct. So help me God,

(Signature) P. C. Musgrove
407 K.F.H. Bldg., Wichita 2, Kansas
(Address)

SUBSCRIBED AND SWORN to before me this 18th day of November, 1948.

Nadine J. Irrel
Notary Public.

My commission expires December 5, 1951

PLUGGING
FILE SEC. 12 Twp 25 R 13w
BOOK PAGE 69 LINE 14

CONTRACTOR'S WELL LOG

Operator Musgrove Petroleum Corporation Farm Name Fair Well No. I
 Location NE $\frac{1}{4}$ SE $\frac{1}{4}$ SW $\frac{1}{4}$ Sec. 12-25-13W.
 Pool Name Leesburg County Stafford State Kansas
 Commencement Date Nov. 3, 1948 Completion Date Nov. 17, 1948

LOG OF WELL

Elevation 1918' DF
 *All measurements from the top of rotary bushing.

DEPTH		FORMATION	DEVIATION	REMARKS:
FROM	TO		FROM VERTICAL	
0	288	Sand-Shale		
288	350	Red Bed		
350	570	Shale-Red Bed	500' - 0°	
570	725	Red Bed		
725	748	Anhydrite		
748	910	Shale-Shells		
910	1270	Shale-Shells	1000' - 0°	
1270	1570	Shale-Shells		
1570	1840	Broken Lime		
1840	1945	Lime		
1945	2140	Lime-Shale	2000' - 0°	
2140	2265	Shale-Lime		
2265	2370	Shale-Lime		
2370	2490	Shale		
2490	2620	Shale	2500' - 0°	
2620	2710	Shale-Lime		
2710	2870	Shale-Lime		
2870	3010	Lime-Shale		
3010	3160	Lime-Shale	3000' - 0°	
3160	3237	Shale-Lime		
3237	3302	Lime		
3302	3395	Shale-Lime		
3395	3440	Lime-Shale		
3440	3473	Shale-Lime		
3473	3585	Shale-Lime		
3585	3665	Lime	3500' - 0°	
3665	3699	Lime		
3699	3740	Lime		
3740	3784	Lime		
3784	3830	Lime		
3830	3866	Lime		
3866	3915	Lime		
3915	3965	Lime		
4010	4060	Lime		
4060	4094	Lime-Shale		
4094	4110	Lime-Shale		
4110	4135	Lime		
4135	4165	Lime		
4165	4175	Lime		

RECORDED
 NOV 20 1948
 STATE OF KANSAS
 COMMISSION
 KANSAS

CASING LEFT IN HOLE AFTER COMPLETION
 Set 315.41' (16 jts.) 8-5/8" OD Casing.

STATE OF KANSAS, COUNTY OF SEDGWICK, ss.

The undersigned certifies that to the best of his knowledge and belief the above facts are true and correct.

C-G DRILLING COMPANY, Inc
 By R. A. Cook
 President

Subscribed and sworn to before me this 18th day of November, 1948.

My commission expires
 June 25, 1951

PLUGGING
 FILE NO. 12-25-13W-12
 LOOK PAGE 69-111-14

Vickrey
 Notary Public