

STATE OF KANSAS  
STATE CORPORATION COMMISSION


Form CP-4

WELL PLUGGING RECORD

Give All Information Completely  
Make Required Affidavit  
Mail or Deliver Report to:  
Conservation Division  
State Corporation Commission  
211 No. Broadway  
Wichita, Kansas

STAFFORD County. Sec. 14 Twp. 25 Rge. 13W (E) (W)  
Location as "NE/CNW/SW" or footage from lines S/2 S/2 SW  
Lease Owner SANTA FE PIPE & SUPPLY  
Lease Name G. RUSSELL Well No. 1  
Office Address P. O. BOX 562 - GREAT BEND, KANSAS  
Character of Well (completed as Oil, Gas or Dry Hole) OIL  
Date well completed SEPTEMBER 2 19 61  
Application for plugging filed APRIL 29 19 64  
Application for plugging approved APRIL 30 19 64  
Plugging commenced APRIL 30 19 64  
Plugging completed MAY 11 19 64  
Reason for abandonment of well or producing formation DEPLETED

NORTH

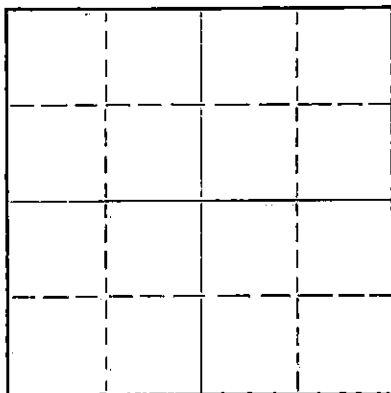

Locate well correctly on above  
Section Plat

If a producing well is abandoned, date of last production \_\_\_\_\_ 19 \_\_\_\_  
Was permission obtained from the Conservation Division or its agents before plugging was commenced? YES

Name of Conservation Agent who supervised plugging of this well ARCHIE ELVING  
Producing formation \_\_\_\_\_ Depth to top \_\_\_\_\_ Bottom \_\_\_\_\_ Total Depth of Well 4317' Feet  
Show depth and thickness of all water, oil and gas formations.

OIL, GAS OR WATER RECORDS

CASING RECORD

FORMATION	CONTENT	FROM	TO	SIZE	PUT IN	PULLED OUT
				8 5/8"	228'	NONE
				5 1/2"	4317'	3616'

Describe in detail the manner in which the well was plugged, indicating where the mud fluid was placed and the method or methods used in introducing it into the hole. If cement or other plugs were used, state the character of same and depth placed, from \_\_\_\_\_ feet to \_\_\_\_\_ feet for each plug set.

PLUGGED BACK WITH SAND FROM 4317' TO 4200'. MIXED AND DUMPED 5 SX. OF CEMENT FROM 4200' TO 4160'. PULLED CASING. MUDDERED HOLE TO 225'. SET 10' ROCK BRIDGE FROM 225' TO 215'. MIXED AND DUMPED 25 SX. OF CEMENT FROM 215' TO 140'. MUDDERED HOLE FROM 140' TO 40'. SET 10' ROCK BRIDGE FROM 40' TO 30'. MIXED AND DUMPED 10 SX. OF CEMENT FROM 30' TO BASE OF THE CELLAR.

RECEIVED  
STATE CORPORATION COMMISSION

JUN 2 1964

CONSERVATION DIVISION  
Wichita, Kansas

(If additional description is necessary, use BACK of this sheet.)  
Name of Plugging Contractor ACE PIPE PULLING COMPANY  
Address P. O. BOX 304 - GREAT BEND, KANSAS

STATE OF KANSAS, COUNTY OF BARTON, ss.  
T. L. NUTT (employee of owner) or (owner or operator) of the above-described

well, being first duly sworn on oath, says: That I have knowledge of the facts, statements, and matters herein contained and the log of the above-described well as filed and that the same are true and correct. So help me God.

(Signature) T. L. Nutt  
P. O. BOX 562 - GREAT BEND, KANSAS  
(Address)

SUBSCRIBED AND SWORN to before me this 23rd day of MAY, 1964

My commission expires JULY 31, 1966

Mary M. Guesnier  
Mary M. Guesnier  
Notary Public.

WELL LOG BUREAU—KANSAS GEOLOGICAL SOCIETY  
508 East Murdock, Wichita, Kansas

COPIES *W*


Company— DUNNE-GARDNER DRILLING CO.  
Farm— G. Russell No. 1

SEC. 14 T. 25 R. 13W  
C S/2 S/2 SW

Total Depth. 4317'  
Comm. 8-22-61  
Shot or Treated.  
Contractor.  
Issued. 2-24-62

Comp. 9-2-61

County Stafford  
KANSAS

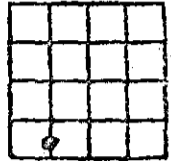

CASING:  
8 5/8" 228' cem w/225 sx.  
5 1/2" 4317'

Elevation. 1927' RB

Production. 90 BOPD

Figures Indicate Bottom of Formations.

sand & shale	100
shale	250
shale & shells	769
Anhydrite	785
shale & shells	1070
shale	1660
shale & shells	1855
lime & shale	2310
shale & lime	3360
lime & shale	3710
lime	3975
lime & shale	4020
lime	4245
lime & shale	4280
lime	4313
lime	4317
Total Depth	

TOPS: SCOUT	
Heebner	3477
Brown Lime	3627
Lansing	3655
Base Kansas City	3920
Conglomerate	4078
Viola	4083
Simpson	4193

**RECEIVED**  
STATE CORPORATION COMMISSION

JUN 2 1964

CONSERVATION DIVISION  
Wichita, Kansas