

STATE OF KANSAS
STATE CORPORATION COMMISSION

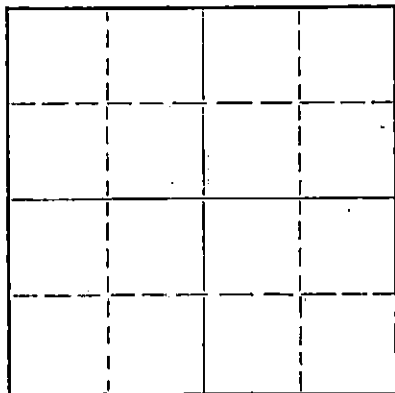
WELL PLUGGING RECORD

Give All Information Completely
Make Required Affidavit
Mail or Deliver Report to:
Conservation Division
State Corporation Commission
311 No. Broadway
Wichita, Kansas

Reno County, Sec. 18 Twp. 25S Rge. (E) 7 (W)

Location as "NE/CNW/SW" or footage from lines SE SE NE
Lease Owner Thunderbird Drilling, Inc.
Lease Name Trembley Well No. 1
Office Address 712 Union Center, Wichita 2, Kansas
Character of Well (completed as Oil, Gas or Dry Hole) Dry Hole
Date well completed May 24 1961
Application for plugging filed May 24 1961
Application for plugging approved May 24 1961
Plugging commenced May 24 1961
Plugging completed May 24 1961
Reason for abandonment of well or producing formation Dry Hole

NORTH



Locate well correctly on above
Section Plat

If a producing well is abandoned, date of last production 19
Was permission obtained from the Conservation Division or its agents before plugging was commenced? Yes

Name of Conservation Agent who supervised plugging of this well Fred Hampel
Producing formation Depth to top Bottom Total Depth of Well 4270 Feet
Show depth and thickness of all water, oil and gas formations.

OIL, GAS OR WATER RECORDS

CASING RECORD

FORMATION	CONTENT	FROM	TO	SIZE	PUT IN	PULLED OUT

Describe in detail the manner in which the well was plugged, indicating where the mud fluid was placed and the method or methods used in introducing it into the hole. If cement or other plugs were used, state the character of same and depth placed, from feet to feet for each plug set.

Plugged hole. Plug 20 sacks cement - 1/4 sack hulls @ 210'.
Plug 10 sacks cement - 1/4 sacks hulls @ 40'.

RECEIVED
STATE CORPORATION COMMISSION
MAY 31 1961
CONSERVATION DIVISION
Wichita, Kansas

(If additional description is necessary, use BACK of this sheet)
Name of Plugging Contractor Thunderbird Drilling, Inc.
Address 712 Union Center, Wichita 2, Kansas

STATE OF Kansas COUNTY OF Sedgwick, ss.
Charles W. Aikins, Jr. (Employee or owner) or (owner or operator) of the above-described well, being first duly sworn on oath, says: That I have knowledge of the facts, statements, and matters herein contained and the log of the above-described well as filed and that the same are true and correct. So help me God.

(Signature) Charles W. Aikins, Jr., President
712 Union Center, Wichita 2, Kansas
(Address)

SUBSCRIBED AND SWORN TO before me this 26th day of May 1961

My commission expires February 1, 1964

Rose Marie Kuhlman Notary Public.



DRILLERS LOG

#1 Trembley

LOCATION: SE SE NE - Section 18
Township 25 South, Range 7 West,
Reno County, Kansas

CONTRACTOR: Thunderbird Drilling, Inc.
712 Union Center
Wichita 2, Kansas

SURFACE CASING: 8-5/8" surface casing set at 220'
with 200 sacks cement, 3 sacks
ammonia chloride, 3 sacks cal-
cium chloride.

ELEVATION: 1573' K. B.
1570' D. F.
1568' G. L.

COMMENCED: May 11, 1961

COMPLETED: May 24, 1961

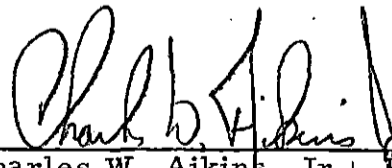
WELL LOG

0 -	50	Sand
50 -	85	Red Bed
85 -	1075	Red Bed and Shale
1075 -	1100	Anhydrite
1100 -	1130	Shale and Shells
1130 -	1383	Lime and Shale
1383 -	3185	Shale and Lime
3185 -	3648	Lime
3648 -	3718	Lime and Shale
3718 -	3794	Lime
3794 -	3867	Cherty Lime
3867 -	3900	Lime
3900 -	3902	Cherty Lime
3902 -	3942	Cherty Lime and Shale
3942 -	4030	Lime and Shale
4030 -	4270	Shale and Lime
4270		Rotary Total Depth

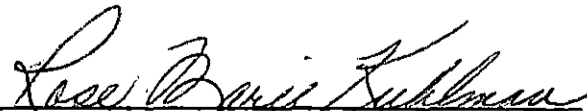
RECEIVED
STATE CORPORATION COMMISSION
MAY 31 1961
CONSERVATION DIVISION
Wichita, Kansas

The undersigned, Charles W. Aikins, Jr., an officer of Thunderbird Drilling, Inc., hereby certifies that the above is a true and correct log of the formations encountered in the drilling of the #1 Trembley as shown in the daily drilling reports.

THUNDERBIRD DRILLING, INC.


Charles W. Aikins, Jr., President

Subscribed and sworn to before me this 26th day of May, 1961.


Rose Marie Kuhlman, Notary Public

My commission expires 2-1-64.