


STATE OF KANSAS
STATE CORPORATION COMMISSION

Give All Information Completely
Make Required Affidavit
Mail or Deliver Report to:
Conservation Division
State Corporation Commission
800 Bitting Building
Wichita, Kansas

WELL PLUGGING RECORD

NORTH

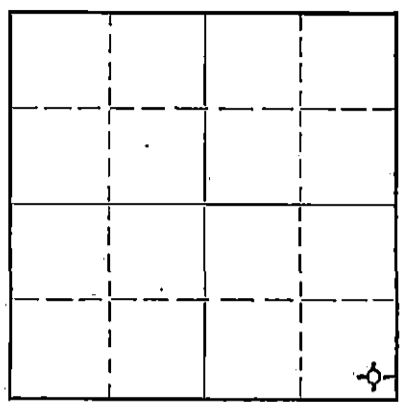

Locate well correctly on above
Section Plat

Reno County. Sec. 8 Twp. 25S Rge. 8W (E) (W)
Location as "NE/CNW $\frac{1}{4}$ SW $\frac{1}{4}$ " or footage from lines SE SE SE
Lease Owner Con Melland et al
Lease Name Miller Well No. I
Office Address 17 W. 12th St., Hutchinson, Kansas
Character of Well (completed as Oil, Gas or Dry Hole) Dry Ho
Date well completed 11-22 19 50
Application for plugging filed " 19
Application for plugging approved " 19
Plugging commenced " 19
Plugging completed " 19
Reason for abandonment of well or producing formation Dry Hole
If a producing well is abandoned, date of last production 19
Was permission obtained from the Conservation Division or its agents before plugging was commenced? Yes

Name of Conservation Agent who supervised plugging of this well C. D. Stough
Producing formation Depth to top Bottom Total Depth of Well 4344 Feet
Show depth and thickness of all water, oil and gas formations.

OIL, GAS OR WATER RECORDS

CASING RECORD

| Formation | Content | From | To | Size | Put In | Pulled Out |
|------------------|---------|------|----|-------|--------|------------|
| Sand and red bed | Water | 10 | 70 | 8-5/8 | 130 | None |
| | | | | | | |
| | | | | | | |
Describe in detail the manner in which the well was plugged, indicating where the mud fluid was placed and the method or methods used in introducing it into the hole. If cement or other plugs were used, state the character of same and depth placed, from feet to feet for each plug set.

Filled hole with very heavy mud. Set bottom plug at 130'. Mixed and poured 15 sacks cement through drill pipe. Filled up with heavy mud. Set top plug at 10' below cellar. Poured 10 sacks cement on top.

STATE CORPORATION COMMISSION
NOV 29 1950
CONSERVATION DIVISION
Wichita, Kansas

(If additional description is necessary, use BACK of this sheet)

Correspondence regarding this well should be addressed to A. D. Allison & Co., Inc.,
Address 715 Brown Building, Wichita 2, Kansas.

STATE OF Kansas, COUNTY OF Sedgwick, ss.
J. A. Allison (employee of owner) or (owner or operator) of the above-described well,
being first duly sworn on oath, says: That I have knowledge of the facts, statements, and matters herein contained and the log of the above-described well as filed and that the same are true and correct. So help me God.

(Signature) J. Allison
715 Brown Building, Wichita, Kansas.
(Address)

SUBSCRIBED AND SWORN to before me this 28th day of November, 19 50
Notary Public.

My commission expires 7-22-53

PLUGGING
FILE SEC 8 T 25 R 8W
BOOK PAGE 45 LINE 4

CON MELLAND, et al
MILLER #1

Sec. 8, Twp. 25S., Rge. 8W.,

Reno County, Kansas.

Total Depth 4344'

Comm: 11-5-50

Comp: 11-21-50

Contr: A. D. ALLISON & CO., INC.,

Production: D & A

CASING RECORD:

8-5/8 130'

FORMATION

DEPTH

| | |
|-------------------------|------------|
| Sand and red bed | 70 |
| Red bed and shells | 130 |
| Red bed, shale & shells | 1050 |
| Salt, shale and shells | 1190 |
| Lime and shale | 1465 |
| Lime | 1710 |
| Lime and shale | 2685 |
| Shale and shells | 2740 |
| Lime and shale | 3140 |
| Lime | 3675 |
| Shale and lime | 3735 |
| Lime and shale | 3835 |
| Shale and lime | 3853 |
| Chat | 3897 |
| Chat and chert | 3932 |
| Lime | 3950 |
| Shale | 4190 |
| Lime | 4230 |
| Sand and shale | 4275 |
| Lime and chat | 4300 |
| Chert and pyrite | 4315 |
| Lime | 4344 T. D. |

TOPS:

| | |
|---------------------|---------|
| Lansing-Kansas City | 3314 |
| Mississippian | 3846 |
| Kinderhook | 3952 |
| Viola | 4185 |
| Simpson | 4219 |
| Sand | 4224-30 |
| Arbuckle | 4306 |

Certified true copy of drillers log.

By

J. Allison

