

STATE OF KANSAS
STATE CORPORATION COMMISSION


Form CP-4

WELL PLUGGING RECORD

Give All Information Completely
Make Required Affidavit
Mail or Deliver Report to:
Conservation Division
State Corporation Commission
211 No. Broadway
Wichita, Kansas

Reno County, Sec. 15 Twp. 25 Rge. 8 (E) W (W)

NORTH

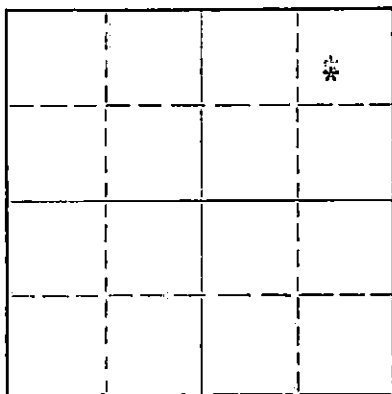

Locate well correctly on above
Section Plat

Location as "NE/CNWSW" or footage from lines
Lease Owner E. H. Riggs
Lease Name Kimes Well No. 1
Office Address _____
Character of Well (completed as Oil, Gas or Dry Hole) Dry Hole
Date well completed 5/27/65 19____
Application for plugging filed 5/27/65 19____
Application for plugging approved 5/27/65 19____
Plugging commenced 5/27/65 19____
Plugging completed 5/27/65 19____
Reason for abandonment of well or producing formation _____

If a producing well is abandoned, date of last production _____ 19____
Was permission obtained from the Conservation Division or its agents before plugging was commenced? Yes

Name of Conservation Agent who supervised plugging of this well Gilbert Toman
Producing formation _____ Depth to top _____ Bottom _____ Total Depth of Well 4255 Feet
Show depth and thickness of all water, oil and gas formations.

OIL, GAS OR WATER RECORDS

CASING RECORD

FORMATION	CONTENT	FROM	TO	SIZE	PUT IN	PULLED OUT
				8 5/8	250'	None

Describe in detail the manner in which the well was plugged, indicating where the mud fluid was placed and the method or methods used in introducing it into the hole. If cement or other plugs were used, state the character of same and depth placed, from _____ feet to _____ feet for each plug set.

Hole filled to 240'. Plug set 1/2 sack hulls on top plug and 25 sacks cement mixed on top plug through drill pipe.
Hole filled to 40'. Plug set 1/2 sack hulls, 10 sacks cement on top of plug through drill pipe. 2 sacks of cement in rat hole.

RECEIVED
STATE CORPORATION COMMISSION

JUN 2 1965
6-2-65

CONSERVATION DIVISION
Wichita, Kansas

(If additional description is necessary, use BACK of this sheet)

Name of Plugging Contractor A. L. Jackson Drilling Co.
Address P. O. Box 339, Great Bend, Kansas

STATE OF Kansas, COUNTY OF Barton, ss.
Harold M. Boyd, Tool pusher (employee of owner) or (owner or operator) of the above-described well, being first duly sworn on oath, says: That I have knowledge of the facts, statements, and matters herein contained and the log of the above-described well as filed and that the same are true and correct. So help me God.

(Signature) Harold M Boyd
P. O. Box 339, Great Bend, Kansas
(Address)

SUBSCRIBED AND SWORN to before me this 31 day of May 19 65

My commission expires 5/9/67

Keata L. Boyd
Keata L. Boyd
Notary Public.

C. L. Miles dba
A. L. JACKSON DRILLING COMPANY
 P. O. Box 339
 Great Bend Kansas

WELL LOG
 KIMS 01
 C SW NE 15-25S-8W
 Reno County Kansas

FROM	TO	
0	250	Red Rock
250	410	Red Bed
410	1040	Red bed and shale
1040	1120	Shale
1120	1270	Salt
1270	1405	Lime and shale
1405	1530	Lime
1530	1805	Shale and lime
1805	1915	Lime
1915	2320	Shale and lime
2320	2375	Lime
2375	3265	Lime and shale
3265	3375	Lime
3375	3595	Lime and shale
3595	3635	Lime
3635	3675	Lime and shale
3675	3720	Lime
3720	3885	Lime and shale
3885	3938	Miss.
3938	4005	Lime
4005	4045	Lime and shale
4045	4190	Shale
4190	4220	Shale and sand
4220	4255	Shale
4255		Total Depth

RECEIVED
 STATE CORPORATION COMMISSION

JUN 2 1965

CONSERVATION DIVISION
 Wichita, Kansas

State of Kansas
 County of Barton

Harold M. Boyd, Tool pusher for A. L. Jackson Drilling Company, being first duly sworn on oath says: that I have knowledge of the facts, statements and matters herein contained and the log of the above described well as filed and that the same are true and correct.

Harold M. Boyd

 Harold M. Boyd

My Commission expires 5/9/67

Reata L. Boyd

 Reata L. Boyd, Notary Public, Barton County,
 Kansas