


STATE OF KANSAS  
STATE CORPORATION COMMISSION  
Give All Information Completely  
Make Required Affidavit  
Mail or Deliver Report to:  
Conservation Division  
State Corporation Commission  
211 No. Broadway  
Wichita, Kansas

### WELL PLUGGING RECORD

Reno County. Sec. 32 Twp. 25S Rge. 10 (E) 10 (W)  
Location as "NE/CNW&SW" or footage from lines NW NW SW  
Lease Owner Tennessee Gas Transmission Company  
Lease Name Walter H. Graber Well No. 1  
Office Address P. O. Box 163 - Great Bend, Kansas  
Character of Well (completed as Oil, Gas or Dry Hole) Dry Hole  
Date well completed July 4, 1959  
Application for plugging filed July 6, 1959  
Application for plugging approved July 8, 1959  
Plugging commenced July 4, 1959  
Plugging completed July 4, 1959  
Reason for abandonment of well or producing formation Dry Hole

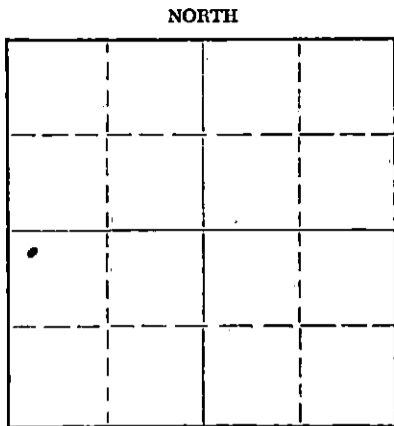

Locate well correctly on above Section Plat

If a producing well is abandoned, date of last production 19  
Was permission obtained from the Conservation Division or its agents before plugging was commenced? Yes

Name of Conservation Agent who supervised plugging of this well Fred W. Hampel  
Producing formation \_\_\_\_\_ Depth to top \_\_\_\_\_ Bottom \_\_\_\_\_ Total Depth of Well 4150 Feet  
Show depth and thickness of all water, oil and gas formations.

#### OIL, GAS OR WATER RECORDS

#### CASING RECORD

FORMATION	CONTENT	FROM	TO	SIZE	PUT IN	PULLED OUT
See Attached Log				8-5/8"	300'	None

Describe in detail the manner in which the well was plugged, indicating where the mud fluid was placed and the method or methods used in introducing it into the hole. If cement or other plugs were used, state the character of same and depth placed, from \_\_\_\_\_ feet to \_\_\_\_\_ feet for each plug set.

Mudded from 4150' to 210', 18 sacks cement, plug at 210',  
Mudded to 40', 10 sacks cement to surface.

RECEIVED  
STATE CORPORATION COMMISSION  
JUL 16 1959  
CONSERVATION DIVISION  
Wichita, Kansas

(If additional description is necessary, use BACK of this sheet)  
Name of Plugging Contractor Prine Drilling Company  
Address Wichita, Kansas

STATE OF KANSAS, COUNTY OF BARTON, ss.  
Glen E. Armour (employee of owner) of the above-described well, being first duly sworn on oath, says: That I have knowledge of the facts, statements, and matters herein contained and the log of the above-described well as filed and that the same are true and correct. So help me God.

(Signature) Glen E. Armour  
P. O. Box 163 - Great Bend, Kansas  
(Address)

SUBSCRIBED AND SWORN TO before me this 15th day of July, 1959

My commission expires October 13, 1962  
John Lemon Notary Public.

PLUGGING  
FILE SEC. 32 T. 25 R. 6 W  
BOOK PAGE 49 LINE 23

ROTARY DRILLING LOG

OPERATOR: Tennessee Gas and Oil Company  
 WALTER H. GRABER NO. 1  
 NW NW SW Sec. 32-25S-6W,  
 Reno County, Kansas

CONTRACTOR: Prime Drilling Company  
 COMM: 6/12/59  
 COMP: 7/5/59

Remarks: Set 8-5/8" surface casing  
 at 309' cemented w/225 sx.  
 regular cement, 2% C.C.

Formations:

Sand	30'
Shale	140'
Shale & Shells	760'
Shale	890'
Anhydrite	925'
Shale, Anhydrite Streaks	1000'
Shale & Lime	1415'
Lime	1515'
Lime & Shale	1750'
Shale & Lime Streaks	1855'
Shale & Lime	2080'
Lime & Shale	2205'
Shale & Lime	2247'
Lime Shale	2260'
Shale & Lime	2475'
Lime & Shale	2526'
Lime	2623'
Lime & Shale	2960'
Lime	3510'
Lime & Shale	3608'
Lime	3629'
Chert & Lime	3655'
Lime	3720'
Lime & Chert	3728'
Chat & Chert	3748'
Lime	3775'
Chert & Lime	3794'
Shale	4008'
Lime & Shale	4025'
Sand	4040'
Lime & Shale	4062'
Sand & Shale	4076'
Sand	4081'
Shale & Lime	4103'
Sand	4125'
Lime	4150'
Rotary Total Depth(D&A):	4150'

RECEIVED  
 STATE CORPORATION COMMISSION

JUL 16 1959

CONSERVATION DIVISION  
 Wichita, Kansas

We certify the above log is true and  
 correct to the best of our knowledge  
 and belief.

PRIME DRILLING COMPANY

  
 L. J. Clampitt

PLUGGING  
 FILE SEC. 32 T. 25 S. R. 6 W.  
 BOOK PAGE 49 LINE 23