

STATE OF KANSAS
STATE CORPORATION COMMISSION


14

WELL PLUGGING RECORD

Give All Information Completely
Make Required Affidavit
Mail or Deliver Report to:
Conservation Division
State Corporation Commission
211 No. Broadway
Wichita, Kansas

Reno County, Sec. 29 Twp. 25 Rge. (E) 6W(W)
Location as "NE/CNW&SWK" or footage from lines SE NE NE
Lease Owner Lario Oil & Gas Company
Lease Name Hornbaker Well No. 1
Office Address 301 S. Market, Wichita 2, Kansas
Character of Well (completed as Oil, Gas or Dry Hole) Oil Well
Date well completed June 14 19 55
Application for plugging filed July 9 19 62
Application for plugging approved July 10 19 62
Plugging commenced July 21 19 62
Plugging completed July 24 19 62
Reason for abandonment of well or producing formation depleted

NORTH

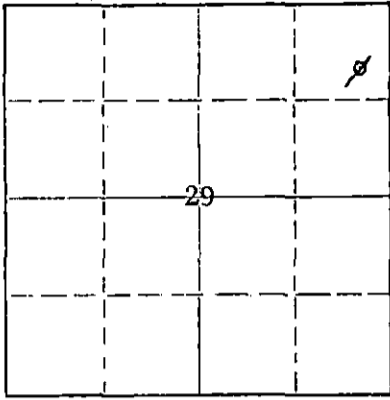

Locate well correctly on above
Section Plat

If a producing well is abandoned, date of last production July 13 19 62
Was permission obtained from the Conservation Division or its agents before plugging was commenced? Yes

Name of Conservation Agent who supervised plugging of this well Herman Justin
Producing formation Misener Sand Depth to top 3992 Bottom 3998 Total Depth of Well 4106 Feet
Show depth and thickness of all water, oil and gas formations.

OIL, GAS OR WATER RECORDS

CASING RECORD

FORMATION	CONTENT	FROM	TO	SIZE	PUT IN	PULLED OUT
		0	296	8 5/8"	Circ. cement	
		0	4104	5 1/2"		3387'

Describe in detail the manner in which the well was plugged, indicating where the mud fluid was placed and the method or methods used in introducing it into the hole. If cement or other plugs were used, state the character of same and depth placed, from _____ feet to _____ feet for each plug set.

Sand from total depth to 2980' with 5 sacks cement to 3950'. Mud to 200'.
Set plug 10' rock bridge, 20 sacks cement to 130', mud to 40'. Set plug 10
sacks cement to base of cellar.

RECEIVED
STATE CORPORATION COMMISSION

JUL 30 1962
7-30-62
CONSERVATION DIVISION
Wichita, Kansas

(If additional description is necessary, use BACK of this sheet)

Name of Plugging Contractor Glen & Smith Pipe Pulling Co.
Address Ellinwood, Kansas

STATE OF KANSAS, COUNTY OF SEDGWICK, ss.
Leo Ross (employee of owner) or (owner or operator) of the above-described well, being first duly sworn on oath, says: That I have knowledge of the facts, statements, and matters herein contained and the log of the above-described well as filed and that the same are true and correct. So help me God.

(Signature) *Leo Ross*

301 S. Market, Wichita 2, Kansas
(Address)

SUBSCRIBED AND SWORN TO before me this 25th day of July, 19 62

Frances Leslie

Notary Public.

My commission expires July 21, 1966



GLOBE OIL & REFINING CO.

Hornbaker No. 1
SE NE NE Sec. 29-25-6W
Reno County, Kansas

Drilling Commenced: 5-6-55
Drilling Completed: 5-29-55
Well Completed: 6-14-55
Drilling Contractor: Group Exploration Co.
Total Depth: 4106
Int. Pot. - 141 bbls. oil, plus 4% water

CASING RECORD:

8 5/8" 300'6" Set @ 296.69
Cem. 235 sacks
5 1/2" 4140.81' Set @ 4104'
Cem. 150 sacks

Formation	Depth
Clay and sand	60
Shale	900
Sandy lime	1160
Lime & shale	1460
Lime	1718
Lime & shale	1755
Lime	1995
Lime & shale	2100
Shale	2275
Shale & shells	2410
Shale & lime	2505
Shale	2514
Shale & lime	2605
Lime	2670
Shale & lime	2750
Shale	2910
Lime	3490
Lime & shale	3550
Varicolored shale	3595
Conglomerate, shale & chert	3615
Lime	3655
Mississippi chert	3680
Lime	3830
Shale	3940
Lime	3961
Shale & sand	3995
Lime	4002
Lime & sand	4015
Shale	4050
Lime	4055
Sand & shale	4070
Shale & sand	4092
Arbuckle lime	4106

Welex perforated 24 holes 3992-3998'
Dowell acidized 250 gallons
Sandfraced with 5500# sand and 6000 gallons
Swabbed 5 BOPH after load oil was recovered

GEOLOGICAL TOPS

Elevation	1553 D.F.	1555 R.B.
Heebner Shale	2701	-1146
Base Oread	2730	-1175
Lansing	2947	-1392
Conglomerate	3583	-2028
Mississippi Chert	3610	-2055
Mississippi Lime	3638	-2083
Kinderhook Shale	3785	-2230
Misener Sand	3990	-2435
Viola	4002	-2447
Simpson Shale	4011	-2456
Simpson Sand	4016	-2461
Arbuckle	4095	-2540

RECEIVED
STATE CORPORATION COMMISSION
JUL 10 1962
CONSERVATION DIVISION
Wichita, Kansas