


STATE OF KANSAS  
STATE CORPORATION COMMISSION

Give All Information Completely  
Make Required Affidavit  
Mail & Deliver Report to:  
Conservation Division  
State Corporation Commission  
1 No. Broadway  
Wichita, Kansas

## WELL PLUGGING RECORD

NORTH

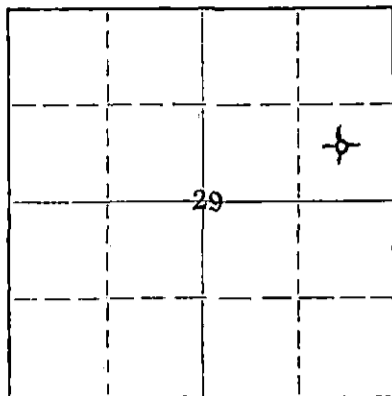

Locate well correctly on above  
Section Plat

Reno County, Sec. 29 Twp. 25S Rge. (E) 6W(W)

Location as "NE/CNW/SW" or footage from lines Gen. SE NE

Lease Owner Lario Oil &amp; Gas Company

Lease Name Hornbaker Well No. 2

Office Address 301 S. Market, Wichita 2, Kansas

Character of Well (completed as Oil, Gas or Dry Hole) Dry Hole

Date well completed October 2 19 61

Application for plugging filed (verbal 10-2-61) October 3 19 61

Application for plugging approved October 2 19 61

Plugging commenced October 2 19 61

Plugging completed October 2 19 61

Reason for abandonment of well or producing formation Dry Hole

If a producing well is abandoned, date of last production 19

Was permission obtained from the Conservation Division or its agents before plugging was commenced? Yes

Name of Conservation Agent who supervised plugging of this well Fred W. Hampel

Producing formation Depth to top Bottom Total Depth of Well 4033 Feet

Show depth and thickness of all water, oil and gas formations.

## OIL, GAS OR WATER RECORDS

## CASING RECORD

FORMATION	CONTENT	FROM	TO	SIZE	PUT IN	PULLED OUT
				8 5/8"	310'	
					Set @ 314.79'	None

Describe in detail the manner in which the well was plugged, indicating where the mud fluid was placed and the method or methods used in introducing it into the hole. If cement or other plugs were used, state the character of same and depth placed, from feet to feet for each plug set.

30 sacks cement plug down drill pipe from 300 to 204'

10 sacks cement plug 10' to 0.

Surface casing cut off 2 1/2' below ground level.

Rat hole filled with cement.

Plugging completed at 10:00 A.M. October 2, 1961.

10-4-61  
OCT 4 1961  
CONSERVATION DIVISION  
Wichita, Kansas

(If additional description is necessary, use BACK of this sheet)

Name of Plugging Contractor White &amp; Ellis Drilling, Inc.

Address Box 448, El Dorado, Kansas

STATE OF KANSAS, COUNTY OF SEDGWICK, ss.

G. R. Kelsey

(employee of owner) or (owner or operator) of the above-described well, being first duly sworn on oath, says: That I have knowledge of the facts, statements, and matters herein contained and the log of the above-described well as filed and that the same are true and correct. So help me God.

(Signature)

301 S. Market, Wichita 2, Kansas

(Address)

SUBSCRIBED AND SWORN TO before me this 3rd day of October, 19 61

My commission expires July 21, 1962

Notary Public.

LARIO OIL & GAS COMPANY  
Hornbaker No. 2  
Gen. SE NE Sec. 29-25S-6W  
Reno County, Kansas

Drilling Commenced: September 18, 1961  
Drilling Completed: October 2, 1961  
Well Completed: October 2, 1961  
Drilling Contractor: White & Ellis Drilling, Inc.  
Total Depth : 4035' Driller's  
I.P. - Dry & Abandoned

Casing Record:  
8 5/8" OD 32# 309.95 (o.a.) Set @ 314.79'  
Cem. w/ 250 sacks

Formation	Depth
Sand & shale	100
Shale & shells	485
Shale	575
Shale & lime	860
Anhydrite	1390
Shale & lime	1560
Lime	1725
Lime & shale	1825
Shale & lime	2060
Lime	2260
Lime & shale	2500
Lime	2664
Shale & lime	2780
Sand	2820
Shale	2842
Sand	2860
Sand & shale	2925
Lime	2937
Shale	2950
Lime	3358
Lime & shale	3600
Mississippi	3618
Lime Mississippi	3792
Shale	4001
Sand & shale	4009
Lime & shale	4019
Sand & shale	4035

GEOLOGICAL TOPS -- K.B. MEAS.	
Elevation	1555' K.B.
	1552' D.F.
	1549' Ground
Heebner	2702 (-1147)
Brown Lime	2925 (-1370)
Lansing	2950 (-1395)
Conglomerate	3590 (-2035)
Mississippian	3600 (-2045)
Mississippian Limestone	3650 (-2095)
Kinderhook	3788 (-2233)
Chattanooga	3972 (-2417)
Misener Zone	3996 (-2442)
Viola	4009 (-2454)
Simpson	4015 (-2460)
Simpson Sand	4016 (-2461)
Total Depth	4033 (-2478)

**RECEIVED**  
STATE CORPORATION COMMISSION  
OCT 11 1961  
CONSERVATION DIVISION  
Wichita, Kansas