


STATE OF KANSAS
STATE CORPORATION COMMISSION

WELL PLUGGING RECORD

All Information Completely
Make Required Affidavit
Mail or Deliver Report to:
Conservation Division
State Corporation Commission
211 No. Broadway
Wichita, Kansas

Reno County. Sec. 28 Twp. 25 Rge. 6W (E) (W)
Location as "NE/CNW/SW" or footage from lines SW SW NE
Lease Owner The El Dorado Refining Company
Lease Name Goering Well No. 1
Office Address 306 Koch Building, Wichita, Kansas
Character of Well (completed as Oil, Gas or Dry Hole) dry hole
Date well completed 1-8-56 19
Application for plugging filed 1-8-56 19
Application for plugging approved 1-8-56 19
Plugging commenced 1-8-56 19
Plugging completed 1-8-56 19
Reason for abandonment of well or producing formation

NORTH

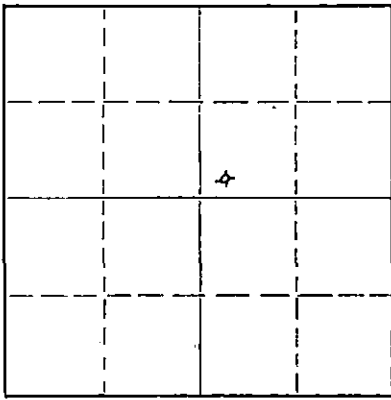

Locate well correctly on above
Section Plat

If a producing well is abandoned, date of last production 19
Was permission obtained from the Conservation Division or its agents before plugging was commenced? yes, verbally

Name of Conservation Agent who supervised plugging of this well Ruel E. Durkee
Producing formation Simpson Depth to top 4014 Bottom Total Depth of Well 4059 Feet
Show depth and thickness of all water, oil and gas formations.

OIL, GAS OR WATER RECORDS

CASING RECORD

FORMATION	CONTENT	FROM	TO	SIZE	PUT IN	PULLED OUT
Surface sand, red bed & shale		0	290	8 5/8"	290'	none
Heebner		2678				
Toronto		2695				
Douglas		2707				
Brown Lime		2901				
Lansing		2931				
Mississippi		3604				
Kinderhook		3781				
Misener		3983				
Viola		3983				
Simpson		4114	4059			

Describe in detail the manner in which the well was plugged, indicating where the mud fluid was placed and the method or methods used in introducing it into the hole. If cement or other plugs were used, state the character of same and depth placed, from feet to feet for each plug set.

Filled hole with heavy mud, set plug at 270' with 15 sax cement & 1/3 sax hulls; set another plug at 25' with 5 sax cement & hulls; leveled location.

(If additional description is necessary, use BACK of this sheet)

Name of Plugging Contractor Ben F. Brack Oil Company, Inc.
Address 309 Brown Building, Wichita, Kansas

STATE OF KANSAS, COUNTY OF SEDGWICK, ss. Bernard D. Grant acting agent
Bernard D. Grant (employee or owner or (owner or operator) of the above-described well, being first duly sworn on oath, says: That I have knowledge of the facts, statements, and matters herein contained and the log of the above-described well as filed and that the same are true and correct. So help me God.

(Signature) Bernard D. Grant
309 Brown Bldg., Wichita 2, Kansas (Address)

SUBSCRIBED AND SWORN TO before me this 11th day of January, 19 56

My commission expires June 11, 1959.

RECEIVED

Notary Public.

PLUGGING
FILE SEC 28 T 25 R 6 W
BOOK PAGE 30 LINE 28

1-12-56

BEN F. BRACK OIL COMPANY, INC.
 309-10 BROWN BUILDING
 WICHITA 2, KANSAS

GOERING #1

SW SW NE

Sec. 28-25S-6W
 Reno County, Kansas
 Commenced: 12-21-55
 Completed: 1-8-56

TOTAL DEPTH: 4059'
 ELEVATION: 1534' DF

WELL LOG

Surface Sand	0 -	80'
Red Bed & Shale		270
Shale		293
Shells, Shale & Lime		825
Lime & Shells		1025
Lime & Shale		1560
Shale & Lime		2380
Lime & Shale		2560
Shale & Lime		2625
Lime & Shale		2885
Shale & Lime		2962
Lime & Shale		3015
Lime		3048
Lime & Shale		3147
Lime		3191
Lime & Shale		3285
Lime		3373
Lime & Shale		3425
Lime		3472
Lime & Sand		3495
Shale & Lime		3560
Shale & Chert		3630
Chert		3645
Chert & Shale		3676
Chert		3715
Chert & Shale		3735
Chert		3767
Chert & Shale		3798
Shale & Lime		3880
Shale		3945
Shale & Lime		3993
Shale		4007
Shale & Lime		4049
Lime & Shale		4059' T.D. D & A

The above depths denote bottom of formations.

CASING

8 5/8" 290'

PLUGGING
 FILE SEC 28-25-6W
 BOOK PAGE 30 LINE 28

REC
 STATE CORP

To the best of my knowledge, the above is a true and correct statement of the depths and formations and where found.

BEN F. BRACK OIL COMPANY, INC.

By Bernard J. Grant

WITNESSED:

Gertrude Crist

January 10, 1956.