


STATE OF KANSAS
STATE CORPORATION COMMISSION

WELL PLUGGING RECORD

Give All Information Completely
Make Required Affidavit
Mail or Deliver Report to:
Conservation Division
State Corporation Commission
211 No. Broadway
Wichita, Kansas

NORTH

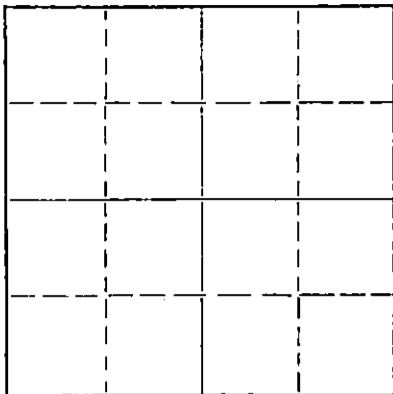

Locate well correctly on above
Section Plat

Reno County. Sec. 33 Twp. 25S Rge. XED 4 (W)
Location as "NE/CNW%SW%" or footage from lines 660' from E & 660' from S, SE/4
Lease Owner Phillips Petroleum Company
Lease Name Cohen Well No. 1
Office Address Box 779, Great Bend, Kansas
Character of Well (completed as Oil, Gas or Dry Hole) Oil
Date well completed January 24, 19 43
Application for plugging filed September 13, 19 57
Application for plugging approved September 16, 19 57
Plugging commenced September 24, 19 57
Plugging completed September 27, 19 57
Reason for abandonment of well or producing formation Uneconomical to operate -
Well shut down since 4-17-57.
If a producing well is abandoned, date of last production 4-17-57 19
Was permission obtained from the Conservation Division or its agents before plugging was com-
menced? Yes

Name of Conservation Agent who supervised plugging of this well Mr. Ruel Durkee
Producing formation Viola Depth to top 4094 Bottom NE Total Depth of Well 4096 1/2 Feet
Show depth and thickness of all water, oil and gas formations.

OIL, GAS OR WATER RECORDS

CASING RECORD

FORMATION	CONTENT	FROM	TO	SIZE	PUT IN	PULLED OUT
<u>Viola</u>	<u>Oil</u>	<u>4094</u>	<u>4096 1/2</u>	<u>8-5/8"</u>	<u>302.97'</u>	<u>None</u>
				<u>5-1/2"</u>	<u>412.69'</u>	<u>3020'</u>

Describe in detail the manner in which the well was plugged, indicating where the mud fluid was placed and the method or methods used in introducing it into the hole. If cement or other plugs were used, state the character of same and depth placed, from _____ feet to _____ feet for each plug set.

Plugged back with sand 4096 1/2-4080'. Dumped 6 sx. cement 4080-4038'. Mudded hole 4038' to 300'. Set 10' rock bridge 300' to 290', 15 sx. cement to 245'. Mudded hole 245' to 25', set 10' rock bridge to 15' and 5 sx. cement to base of cellar. Well plugged and abandoned 12:00 Noon 9-27-57.

(If additional description is necessary, use BACK of this sheet)

Name of Plugging Contractor West Supply Company
Address Chase, Kansas

STATE OF Kansas, COUNTY OF Barton, ss.
A. J. Willis (employee of owner ~~and~~ notary public)

well, being first duly sworn on oath, says: That I have knowledge of the facts, statements, and matters herein contained and the log of the above-described well as filed and that the same are true and correct. So help me God.

(Signature) A. J. Willis
Box 779, Great Bend, Kansas
(Address)

SUBSCRIBED AND SWORN TO before me this 30th day of September, 19 57

My commission expires 11-18-57

[Signature]
Notary Public.

OCT 2 - 1957
10-2-57
CONSERVATION DIVISION
WICHITA, KANSAS

PLUGGING
FILE SEC 33 T. 25 R. 4W
BOOK PAGE 45 LINE 2

Phillips Petroleum Company

EXPLORATION RECORD

Cohen No. 1 - 660' from East and 660' from South line of SE/4 Sec. 33-25S-4W,
Renocounty, Kansas

Lease Cohen

Well 1

Formation Name	Top	Base	Remarks
Shale and sand	0	120	
Shale and shells	120	740	
Anhydrite	740	775	
Shale and shells	775	890	
Broken lime and gyp	890	1040	
Broken lime and shale	1040	1202	
Shale and lime	1202	1240	
Lime and sand and shale	1240	1310	
Shale and lime shells	1310	1420	
Lime and shale	1420	1660	
Shale	1660	1841	
Shale and lime	1841	1986	
Shale	1986	2155	
Lime	2155	2345	
Lime and shale	2345	2405	
Lime	2405	2498	
Shale and broken lime	2498	2515	
Lime	2515	2550	
Broken lime	2550	2625	
Lime	2625	3595	
Lime and shale	3595	3635	
Chat	3635	3688	
Chat and missississippi lime	3688	3720	
Miss. lime	3720	3746	
Lime	3746	3820	
Lime Miss.	3820	3860	
Lime	3860	3925	
Lime and chert	3925	3938	
Lime	3938	3950	
Lime and shale	3950	3995	
Shale	3995	4094	
Lime	4094	4096 $\frac{1}{2}$	Top Viola 4094'

3635
769

2866
Wans.

PLUGGING
FILE SEC. 33 T. 25. R. 4W
BOOK PAGE 45 LINE 22

RECORDED
STATE COMMISSION
OCT 2 - 1957
CONSERVATION DIVISION
Wichita, Kansas