


STATE OF KANSAS
STATE CORPORATION COMMISSION

Give All Information Completely
Make Required Affidavit
Mail or Deliver Report to:
Conservation Division
State Corporation Commission
211 No. Broadway
Wichita, Kansas

WELL PLUGGING RECORD

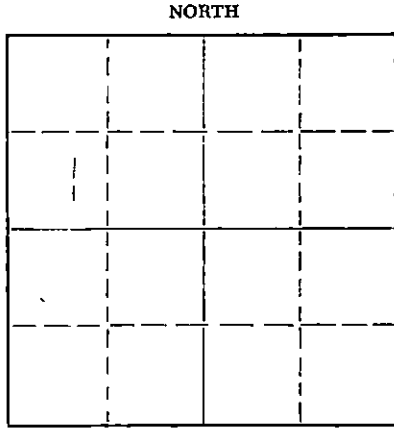

Locate well correctly on above
Section Plat

Reno County, Sec. 33 Twp. 25S Rge. (E) 4 (W)
Location as "NE/CNW/SW" or footage from lines NE NE SE
Lease Owner Phillips Petroleum Company
Lease Name Last Well No. 1
Office Address Box 779 - Great Bend, Kansas.
Character of Well (completed as Oil, Gas or Dry Hole) Oil
Date well completed August 23, 1949 19
Application for plugging filed March 18, 1958 19
Application for plugging approved March 20, 1958 19
Plugging commenced March 26, 1958 19
Plugging completed March 31, 1958 19
Reason for abandonment of well or producing formation Uneconomical to operate

If a producing well is abandoned, date of last production February 28, 1958 19
Was permission obtained from the Conservation Division or its agents before plugging was commenced? Yes

Name of Conservation Agent who supervised plugging of this well Mr. Fed Hampel
Producing formation Viola Depth to top 4095 Bottom _____ Total Depth of Well 4098 Feet
Show depth and thickness of all water, oil and gas formations.

OIL, GAS OR WATER RECORDS

CASING RECORD

FORMATION	CONTENT	FROM	TO	SIZE	PUT IN	PULLED OUT
Mississippi Chat	Dry	3644		8 5/8"	305'	None
Meisner Sand	dry	4075		5 1/2"	4093'	
Sylvan Shale	Dry	4078				
Viola	Oil	4095	4098			

Describe in detail the manner in which the well was plugged, indicating where the mud fluid was placed and the method or methods used in introducing it into the hole. If cement or other plugs were used, state the character of same and depth placed, from _____ feet to _____ feet for each plug set.

Plugged back with sand from 4098' to 4080'. Dumped 5 sx. cement to 4045'. Mudded hole to 260'. Set rock beidge to 250'. Dumped 20 sx. cement to 190'. Mudded hole to 40'. Set rock bridge to 30'. Filled to base of cellar with 10 sx. cement.

RECEIVED
STATE CORPORATION COMMISSION

APR 4 1958

CONSERVATION DIVISION
Wichita, Kansas

(If additional description is necessary, use BACK of this sheet)
Name of Plugging Contractor West Supply Company
Address Chase, Kansas.

STATE OF KANSAS, COUNTY OF BARTON, ss.
A. J. Willis (employee of owner) or (~~owner or operator~~) of the above-described well, being first duly sworn on oath, says: That I have knowledge of the facts, statements, and matters herein contained and the log of the above-described well as filed and that the same are true and correct. So help me God!

(Signature) A. J. Willis
Box 779 - Gt. Bend, Kansas.
(Address)

SUBSCRIBED AND SWORN TO before me this 1st day of April, 19 58

My commission expires 11/18/61 _____
Joseph M. Beal Notary Public.

PLUGGING
FILE SEC. 33 T. 26 R. 46
BOOK PAGE 89 LINE 24

EXPLORATION RECORD

Lease Last

Well 1

Formation Name	Top	Base	Remarks
Shale and Lime	280	318	
Shale and Shells	318	750	
Anhydrite	750	800	
Shale and Shells	800	1010	
Shale and Lime	1010	1465	
Shale	1465	2135	
Shale and Lime	2135	2335	
Shale	2335	2445	
Broken Lime	2445	2585	
Lime and Shale	2585	2650	
Lime	2650	3628	
Lime and Shale	3628	3658	Mississippi Chat 3644
Chat	3658	3674	
Lime	3674	3901	
Broken Lime	3901	3950	
Shale	3950	3962	
Shale		4080	Meisner Sand 4075 Sylvan Shale 4078
Sand	4080	4083	
Shale	4083	4095	
Viola Lime	4095	4098	Viola Lime 4095

PLUGGING
 FILE SEC. 33 T. 26 R. 46
 BOOK PAGE 89 LINE 24

RECEIVED
 STATE CORPORATION COMMISSION
 APR 4 1958
 CONSERVATION DIVISION
 Wichita, Kansas