


STATE OF KANSAS
STATE CORPORATION COMMISSION

Give All Information Completely
Make Required Affidavit
Mail or Deliver Report to:
Conservation Division
State Corporation Commission
800 Bitting Building
Wichita, Kansas

WELL PLUGGING RECORD

NORTH

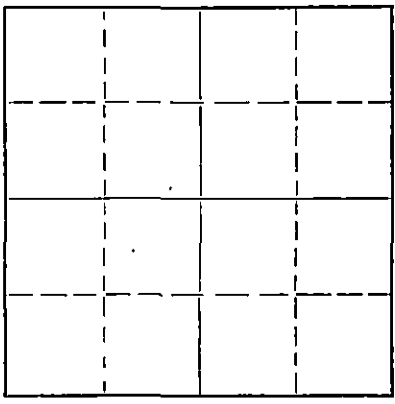

Locate well correctly on above
Section Plat

Reno County. Sec. 33 Twp. 25S Rge. ~~20E~~ 4 (W)
Location as "NE/CNW/SW" or footage from lines. NE SE NE
Lease Owner Phillips Petroleum Company
Lease Name Cooley Well No. 2
Office Address Box 779, Great Bend, Kansas
Character of Well (completed as Oil, Gas or Dry Hole) Oil
Date well completed September 1, 1944 19
Application for plugging filed 3-12-53 19
Application for plugging approved 3-13-53 19
Plugging commenced 3-19-53 19
Plugging completed 3-24-53 4:00 p.m. 19
Reason for abandonment of well or producing formation
Uneconomical to operate
If a producing well is abandoned, date of last production 9-17-51 19
Was permission obtained from the Conservation Division or its agents before plugging was commenced? yes

Name of Conservation Agent who supervised plugging of this well Ruel Durkee, Box 597, McPherson, Kansas
Producing formation Viola Depth to top 4110 Bottom 4111 1/2 Total Depth of Well 4111 1/2 Feet
Show depth and thickness of all water, oil and gas formations.

OIL, GAS OR WATER RECORDS

CASING RECORD

FORMATION	CONTENT	FROM	TO	SIZE	PUT IN	PULLED OUT
Miss.	Dry	3657	NR	8-5/8"	302.55'	None
Misener	Dry	4089	NR	5-1/2"	4135.96'	2873'
Viola	Oil	4110'	4111 1/2'			

Describe in detail the manner in which the well was plugged, indicating where the mud fluid was placed and the method or methods used in introducing it into the hole. If cement or other plugs were used, state the character of same and depth placed, from _____ feet to _____ feet for each plug set.

While performing reconditioning operations, set bridging plug at 3290'. Plugged back with sand from 3290-3260' and with 6 sx cement from 3260' to 3212'; mudded hole 3212' to 250' - dumped 10' rock & 15 sx cement from 250' to 135'. Mudded hole to 15'. Dumped 5 sx cement in filling to base of collar. Plugged and abandoned 4:00 p.m. 3-24-53. Final Report.

RECEIVED
STATE CORPORATION COMMISSION
MAR 27 1953
CONSERVATION DIVISION
Wichita, Kansas

(If additional description is necessary, use BACK of this sheet)
Name of Plugging Contractor West Supply Company
Address Chase, Kansas

STATE OF Kansas, COUNTY OF Barton, ss.
A. J. Willis (employee of owner) or (owner) of the above-described well, being first duly sworn on oath, says: That I have knowledge of the facts, statements, and matters herein contained and the log of the above-described well as filed and that the same are true and correct. So help me God.

(Signature) [Signature]
Box 779, Great Bend, Kansas
(Address)

SUBSCRIBED AND SWORN TO before me this 25th day of March, 19 53

[Signature]
Notary Public.

My commission expires November 18, 1953

PLUGGING
FILE SEC-33 T-25 R-4W
BOOK PAGE 1 LINE 19

Formation Record

Lease Cooley

Well No. 2

FROM	TO	Formation	REMARKS
0	340	Sand and Shale	ELEVATION 1561 DF
340	490	Shale and Shells	
490	730	Shale and Salt	
730	1300	Shale and Lime	
1300	1445	Lime	
1445	1670	Lime and Shale	
1670	1860	Shale	
1860	1960	Shale	
1960	2510	Shale and Lime	
2510	2525	Shale	
2525	3220	Lime	
3220	3248	Lime (Hard)	
3248	3268	Lime (Sandy)	
3268	3280	Lime and Shale	
3280	3325	Lime	
3325	3546	Lime	
3546	3651	Shale	
3651	3672	Chat	Top Miss. 3657'
3672	3978	Lime	
3978	4094	Shale	Top Misener 4089'
4094	4111 $\frac{1}{2}$	Shale and Lime	Top Viola 4110'. por & sat in smpls Took DST w/packer set 4106-12 & rec. 760' oil & 240' water.

PLUGGING

FILE SEC 33 T 25 R 4 W

BOOK PAGE 1 LINE 12