


STATE OF KANSAS
STATE CORPORATION COMMISSION

WELL PLUGGING RECORD

Give All Information Completely.
Make Required Affidavit
Mail or Deliver Report to
Conservation Division
State Corporation Comm.
245 North Water
Wichita, KS 67202

Reno County, Sec. 9 Twp. 25 Rge. 5 E/W
Location as "NE/CNW $\frac{1}{4}$ /SW $\frac{1}{4}$ " or footage from lines
C NE NW

Lease Owner Americo Petroleum, Inc.
Lease Name Astle Well No. 1
Office Address P.O. Box 1459, Hutchinson, Kansas
Character of Well (Completed as Oil, Gas or Dry Hole) 67501
gas

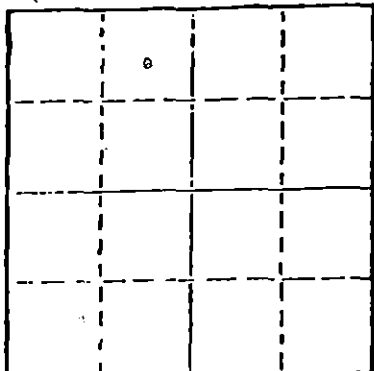

Locate well correctly on above
Section Plot

Date Well completed 19
Application for plugging filed Oct. 2 1979
Application for plugging approved 19
Plugging commenced Oct. 9 1979
Plugging completed Oct. 15 1979
Reason for abandonment of well or producing formation
depleted

If a producing well is abandoned, date of last production 19

Was permission obtained from the Conservation Division or
its agents before plugging was commenced? yes

Name of Conservation Agent who supervised plugging of this well Gilbert Toman
Producing formation Depth to top Bottom Total Depth of Well 3600
Show depth and thickness of all water, oil and gas formations.

OIL, GAS OR WATER RECORDS

CASING RECORD

FORMATION	CONTENT	FROM	TO	SIZE	PUT IN	PULLED OUT
			215'	8 5/8"	215'	none
			3570'	5 1/2"	3570'	2513.89

Describe in detail the manner in which the well was plugged, indicating where the mud fluid
was placed and the method or methods used in introducing it into the hold. If cement or other
plugs were used, state the character of same and depth placed, from _____ feet to
_____ feet for each plug set.

Sanded back to 3450' and dumped 5 sacks of cement.

Set rock bridge at 300' to 280'. Plugged well with 4 yards of ready mix
cement.

STATE RECEIVED
CORPORATION COMMISSION
10-17-79
OCT 17 1979
CONSERVATION DIVISION
Wichita, Kansas

(If additional description is necessary, use BACK of this sheet)


Name of Plugging Contractor GLENN'S CASING PULLING INC.
Box 113, Ellinwood, Kansas 67526

STATE OF KANSAS COUNTY OF BARTON, ss.
Evelyn Roth (employee of owner) or (owner or operator)
of the above-described well, being first duly sworn on oath, says: That I have knowledge of
the facts, statements, and matters herein contained and the log of the above-described well
as filed and that the same are true and correct. So help me God.

(Signature) Evelyn Roth
Ellinwood, Kansas

(Address)

SUBSCRIBED AND SWORN TO before me this 16th day of October, 1979.

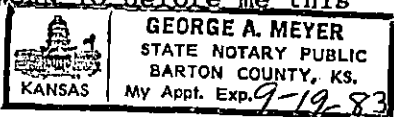

George A. Meyer
Notary Public.

My commission expires _____