


STATE OF KANSAS
STATE CORPORATION COMMISSION

Give All Information Completely
Make Required Affidavit
Mail or Deliver Report to:
Conservation Division
State Corporation Commission
800 Bitting Building
Wichita, Kansas

WELL PLUGGING RECORD

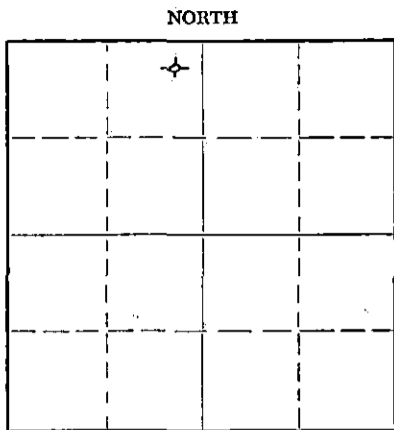

Locate well correctly on above
Section Plat

Stafford County, Sec. 22 Twp. 25S Rge. 11 (E) W (W)
Location as "NE/CNW/SW" or footage from lines NE/4 NE/4 NW/4
Lease Owner Birmingham-Bartlett Drilling Co. et al
Lease Name Tarrant Well No. 1
Office Address 300 Kaufman Building, Wichita 2, Kansas
Character of Well (completed as Oil, Gas or Dry Hole) Dry Hole
Date well completed May 7 19 53
Application for plugging filed (Verbal) May 7 19 53
Application for plugging approved (Verbal) (Letter of approval) May 7 19 53
Plugging commenced May 7 19 53
Plugging completed May 7 19 53
Reason for abandonment of well or producing formation Dry Hole

If a producing well is abandoned, date of last production 19
Was permission obtained from the Conservation Division or its agents before plugging was commenced? Yes

Name of Conservation Agent who supervised plugging of this well M. A. Rives
Producing formation Viola Test Depth to top 3958' Bottom Total Depth of Well 3980 Feet
Show depth and thickness of all water, oil and gas formations.

OIL, GAS OR WATER RECORDS

CASING RECORD

FORMATION	CONTENT	FROM	TO	SIZE	PUT IN	PULLED OUT
		0	235'	8-5/8"	235'	none

Describe in detail the manner in which the well was plugged, indicating where the mud fluid was placed and the method or methods used in introducing it into the hole. If cement or other plugs were used, state the character of same and depth placed, from feet to feet for each plug set.

Mixed and poured through drill pipe 20 sacks of cement. On bottom plug set at 230', 10 sacks cement on top. Plug set at 35'.

RECEIVED
STATE CORPORATION COMMISSION
MAY 12 1953
672-53
CONSERVATION DIVISION
Wichita, Kansas

(If additional description is necessary, use BACK of this sheet)
Name of Plugging Contractor Birmingham-Bartlett Drilling Co.
Address 300 Kaufman Building, Wichita 2, Kansas

STATE OF Kansas, COUNTY OF Sedgwick
Richard Hindery, partner of Birmingham-Bartlett Drilling Co., owner and operator,
being first duly sworn on oath, says: That I have knowledge of the facts, statements, and matters herein contained and the log of the above-described well as filed and that the same are true and correct. So help me God. BIRMINGHAM-BARTLETT DRILLING CO.

(Signature) By Richard Hindery
300 Kaufman Building, Wichita 2, Kansas
(Address)

SUBSCRIBED AND SWORN TO before me this 11th day of May 1953
Vivian J. Jinger
Notary Public.

My commission expires November 29, 1954

PLUGGING
FILE SEC 22 T 25 R 11 W
BOOK PAGE 99 LINE 31

TARRANT NO. 1 WELL

LOCATION: NE/4 NE/4 NW/4
Section 22-255-11W
Stafford County, Kansas

SPUDDED: 4-28-53
COMPLETED: 5-7-53

OPERATOR and CONTRACTOR: Birmingham-Bartlett Drilling Co.

SURFACE CASING: 8-5/8" casing cemented at 235' with 225 sacks cement and 3 cc.

OIL STRING: None set. Dry and Abandoned.

L.O.G.

(figures indicate bottom of formation)

0 -	170	Sand
	233	Red bed and shells
	700	Red bed and shale
	1450	Shale and shells
	2240	Broken lime
	2525	Lime and shale
	2710	Shale and shells
	3085	Lime and shale
	3425	Lime
	3459	Shale
	3480	Brown lime
	3877	Lime
	3945	Shale and lime
	3963	Shale
	3980	Lime
	3980	RTD - D & A

The undersigned, Richard Hindery, one of the partners of Birmingham-Bartlett Drilling Co., hereby certifies that the above is a true and correct log of the formations encountered in drilling the Tarrant No. 1 Well as shown in the daily drilling reports.

BIRMINGHAM-BARTLETT DRILLING CO.

By Richard Hindery

Subscribed and sworn to before me
this 11th day of May 1953.

Vivian J. Yinger
Notary Public

My commission expires November 29, 1954

