

STATE OF KANSAS
STATE CORPORATION COMMISSION


WELL PLUGGING RECORD

Give All Information Completely
Make Required Affidavit
Mail or Deliver Report to:
Conservation Division
State Corporation Commission
800 Bittling Building
Wichita, Kansas

OR
FORMATION PLUGGING RECORD

Strike out upper line
when reporting plug-
ging off formations.

NORTH

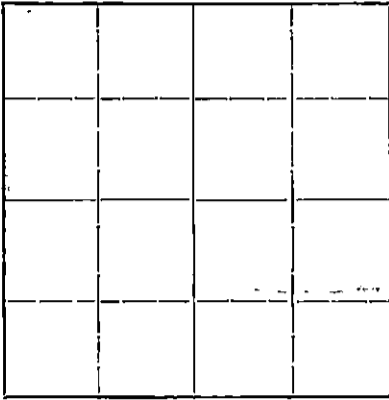

Locate well correctly on above
Section Plat

Stafford County. Sec. 22 Twp. 25 Rge. 11 (E) W. (W)
Location as "NE 1/4 NW 1/4 SW 1/4" or footage from lines. CEL NE NE
Lease Owner. Vickers Petroleum Co.
Lease Name. Stewart et al Well No. 1
Office Address. 201 W-K-H Bldg. Wichita, Kansas
Character of Well (completed as Oil, Gas or Dry Hole) DRY Hole
Date, well completed. 1-10-41 19.
Application for plugging filed. 1-10-41 19.
Application for plugging approved. 1-10-41 19.
Plugging Commenced. 1-10-41 19.
Plugging Completed. 1-11-41 19.
Reason for abandonment of well or producing formation.

If a producing well is abandoned, date of last production 19.
Was permission obtained from the Conservation Division or its agents before plugging was com-
menced? Yes

Name of Conservation Agent who supervised plugging of this well. Mr. C. T. Alexander
Producing formation. Depth to top. Bottom. Total Depth of Well. Feet
Show depth and thickness of all water, oil and gas formations.

OIL, GAS OR WATER RECORDS


CASING RECORD

Formation	Content	From	To	Size	Put In	Pulled Out
Surface		0	212	12 1/8"	212	none

Describe in detail the manner in which the well was plugged, indicating where the mud fluid was placed and the method or methods used in introducing it into the hole. If cement or other plugs were used, state the character of same and depth placed, from feet to feet for each plug set.

Filled hole with mud from 4072 to 212' --- Set Hallibutton wooden plug. Cemented to 195' and filled with mud to 5' below base of cellar where a plug was set and hole was filled with cement to the base of cellar.

PLUGGING
FILE NO. 22 25R 111A
BOOK PAGE 126 LINE 44

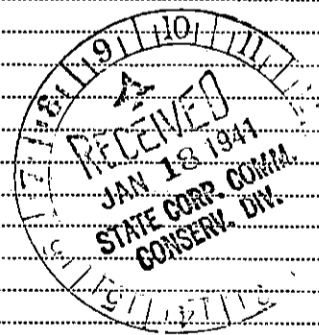

(If additional description is necessary, use BACK of this sheet)

Correspondence regarding this well should be addressed to Vickers Petroleum Co.
Address 201 W-K-H Bldg. Wichita, Kansas

STATE OF Kansas, COUNTY OF Sedgwick, ss.
Mr. John M. Little (employee of owner) or (owner or operator) of the above-described well,

being first duly sworn on oath, says: That I have knowledge of the facts, statements, and matters herein contained and the log of the above-described well as filed and that the same are true and correct. So help me God.

(Signature) [Signature]
201 W-K-H Bldg. Wichita, Kansas (Address)

SUBSCRIBED AND SWORN to before me this 17th day of January, 19 41

My commission expires Oct. 24, 1944

Notary Public.



VICKERS PETROLEUM COMPANY
Stewart et al #1
CEL Ne Ne 22-25-11W
Stafford Countym Kansas

Contractor: Jayhawk Oil Company

Commenced: Dec. 22, 1940
Completed: Jan. 11, 1941

Casing Record: 12 $\frac{1}{2}$ " 212' cemented w/ 183 sacks

0 to 170	Sand
226	Red bed
440	Shale, shells, red bed
560	Red Bed
580	Anhydrite
920	Shale, shells, red bed
1375	Red bed, shale, shells & salt
1560	Shale & shells
1595	Anhydrite
1610	Shale & shells
1850	Lime & shale
1888	Lime
2765	Lime & shale
3315	Lime
3495	Lime & shale
3660	Lime
3705	Lime & sand
3765	Broken Lime
3795	Lime
3868	Lime & shale
3870	Conglomerate
3900	Lime & shale
3910	Coke
3935	Chert
3981	Lime & shale
4000	Shale & sand
4063	Shale
4072 T.D.	Lime

D & A no shows.

