15-185-01422-0000


STATE OF KANSAS
STATE CORPORATION COMMISSION

Form CP-4

Give All Information Completely
Make Required Affidavit
Mail or Deliver Report to:
Conservation Division
State Corporation Commission
211 No. Broadway
Wichita, Kansas

WELL PLUGGING RECORD

NORTH

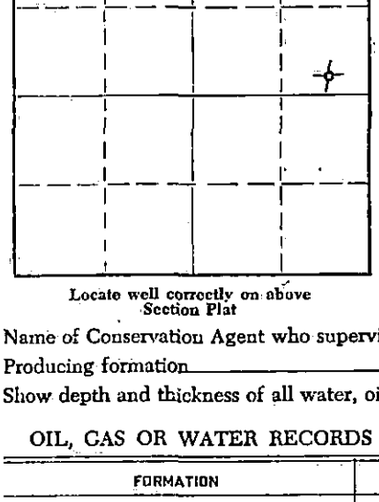

Locate well correctly on above Section Plat

Stafford County. Sec. 16 Twp. 25 Rge. 11 (E) W (W)
Location as "NE/CNW¼SW¼" or footage from lines S/2 SE/4 NE/4
Lease Owner Twyliah O. Gaskill
Lease Name Nagle Well No. 1
Office Address 633 Beacon Building, Tulsa 3, Oklahoma
Character of Well (completed as Oil, Gas or Dry Hole) Dry Hole
Date well completed March 26 19 63
Application for plugging filed March 26 19 63
Application for plugging approved March 26 19 63
Plugging commenced March 26 19 63
Plugging completed March 26 19 63
Reason for abandonment of well or producing formation Dry Hole

If a producing well is abandoned, date of last production 19
Was permission obtained from the Conservation Division or its agents before plugging was commenced? Yes

Name of Conservation Agent who supervised plugging of this well Archie Elving
Producing formation Depth to top Bottom Total Depth of Well 3,957 Feet
Show depth and thickness of all water, oil and gas formations.

OIL, GAS OR WATER RECORDS — CASING RECORD

FORMATION	CONTENT	FROM	TO	SIZE	PUT IN	PULLED OUT
				10 3/4"	257'	Cmtd w/250 sax

Describe in detail the manner in which the well was plugged, indicating where the mud fluid was placed and the method or methods used in introducing it into the hole. If cement or other plugs were used, state the character of same and depth placed, from feet to feet for each plug set.

Fill w/heavy mud to 250'
Set bridge plug @250' w/ 1/4 sax hulls on plug
Dump 30 sax cement on plug thru 4 1/2" drill pipe
Fill w/heavy mud to 40'
Set bridge plug @ 40' w/ 1/4 sax hulls on plug
Dump 20 sax cement on plug to cellar

RECEIVED
STATE CORPORATION COMMISSION
APR 2 1963
CONSERVATION DIVISION
Wichita, Kansas

(If additional description is necessary, use BACK of this sheet)

Name of Plugging Contractor Shields Drilling Co., Inc.
Address Shields Building, Russell, Kansas

STATE OF Kansas, COUNTY OF Russell, ss.
R. L. Shields, contractor (employee of owner) or (owner or operator) of the above-described well, being first duly sworn on oath, says: That I have knowledge of the facts, statements, and matters herein contained and the log of the above-described well as filed and that the same are true and correct. So help me God.

(Signature) R L Shields, V Pres.
Shields Building, Russell, Kansas
(Address)

SUBSCRIBED AND SWORN TO before me this 28th day of March, 19 63

Delphine A. Becker
Notary Public.

My commission expires November 9, 1963


Shields

Russell, Kansas

WELL LOG

Operator: Twyliah O. Gaskill
Well: Nagle #1
Commenced: March 17, 1963
Completed: March 26, 1963
Contractor: Shields Drilling Co., Inc.

Well Description: S/2 SE/4 NE/4
Sec. 16 - 25S - 11W
Stafford County, Kansas

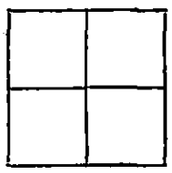

Elevation:
Treatment:

Production: D & A

Tops:

CASING RECORD

Size	Run	Pulled
10 3/4"	257'	Cmtd w/250 sax

Figures Indicate Bottom of Formations

Sand and shale	258'
Shale, shells and redbed	1,410'
Shale	1,450'
Anydrite	1,460'
Shale and lime	1,645'
Lime	1,785'
Lime and shale	3,480'
Lime	3,770'
Lime and chert	3,825'
Lime and shale	3,950'
Lime and chert	3,957' RTD

RECEIVED
STATE CORPORATION COMMISSION
APR 2 1963
CONSERVATION DIVISION
Wichita, Kansas

Notes

DST #1 2,657' - 94' Tool open 1 hr. Recovered 350' SW BHP - 926#/20 Min.

DST #2 3,952' - 57' Tool open 1 hr. w/fair increasing blow. Recovered 670' SW
BHP - 628#/30"