


STATE OF KANSAS
STATE CORPORATION COMMISSION
200 Colorado Derby Bldg.
Wichita, Kansas 67202

Form CP-4
Rev. 12-15-80

WELL PLUGGING RECORD

Give All Information Completely
Make Required Affidavit

COUNTY Stafford SEC. 28 TWP. 25S RGE. 11 E/W
Location as in quarters or footage from lines:
C N/2 S/2 SW

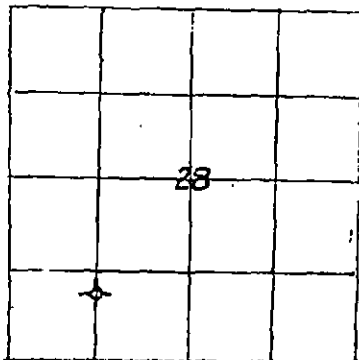

Lease Owner Texas Energies, Inc.
Lease Name Hodgins Well No. 1-28
Office Address P.O. Box 947 Pratt, KS
Character of Well (Completed as Oil, Gas or Dry Hole): Dry Hole
Date Well Completed 10-06-82
Application for plugging filed 10-06-82
Plugging commenced 10-06-82
Plugging completed 10-06-82
Reason for abandonment of well or producing formation Dry Hole

Locate Well
correctly on above
Section Platt.

Was permission obtained from the Conservation Division or it's
Agent's before plugging was commenced? Yes

Name of Conservation Agent who supervised plugging of this well Steve Durrant

Producing formation — Depth to top — bottom — T.D. 4280

Show depth and thickness of all water, oil and gas formations.

OIL, GAS OR WATER RECORDS

Casing Record

Formation	Content	From	To	Size	Put in	Pulled Out
				8 5/8	302	None

Describe in detail the manner in which the well was plugged, indicating where the mud fluid was placed and the method or methods used in introducing it into the hold. If cement or other plugs were used, state the character of same and depth placed, from feet to feet for each plug set.

Plugged well with 145 sxs 50-50 poz mix 4% Gel 3% CC
as follows:

- cement plug at 780' with 70 sxs
- cement plug at 300' with 40 sxs
- wood plug, 1 sx hulls and 10 sxs at 40'
- rathole with 10 sxs
- mousehole with 10 sxs
- water well with 5 sxs

(If additional description is necessary, use BACK of this sheet)

Name of Plugging Contractor Wheatstate Drilling

STATE OF Kansas COUNTY OF Pratt, ss.
E. H. Bittner (employee of owner) or ~~(owner or operator)~~ of the
above-described well, being first duly sworn on oath, says: That I have knowledge of the
facts, statements, and matters herein contained and the log of the above-described well as
filed and that the same are true and correct. So help me God.

(Signature) E. H. Bittner
P.O. Box 947 Pratt, KS 67124
(Address)

SUBSCRIBED AND SWORN TO before me this day of October

My Commission expires: April 23, 1983

