


STATE OF KANSAS
STATE CORPORATION COMMISSION
Give All Information Completely
Make Required Affidavit
Mail or Deliver Report to:
Conservation Division
State Corporation Commission
211 No. Broadway
Wichita, Kansas

WELL PLUGGING RECORD

STAFFORD County. Sec. 32 Twp. 25S Rge. 11W (E) (W)
Location as "NE/CNW%SW%" or footage from lines SE-SE-SE
Lease Owner CONTINENTAL OIL COMPANY - GEORGE A. CARLSON
Lease Name RILEY #1 Well No. 1
Office Address JCT HIWAY 96 & BROADWAY, GREAT BEND, KANSAS
Character of Well (completed as Oil, Gas or Dry Hole)
Date well completed 11-10-63 19 63
Application for plugging filed 11-10 19 63
Application for plugging approved 11-11 19 63
Plugging commenced 11-11 19 63
Plugging completed 11-11 5:00 P.M. 19 63
Reason for abandonment of well or producing formation DRY

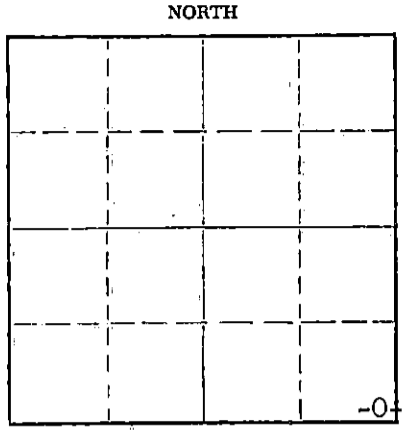

Locate well correctly on above Section Plat

If a producing well is abandoned, date of last production 19
Was permission obtained from the Conservation Division or its agents before plugging was commenced?

Name of Conservation Agent who supervised plugging of this well
Producing formation Depth to top Bottom Total Depth of Well 4350 Feet
Show depth and thickness of all water, oil and gas formations.

OIL, GAS OR WATER RECORDS CASING RECORD

FORMATION	CONTENT	FROM	TO	SIZE	PUT IN	PULLED OUT
		0	248	10 3/4	10/25/63	

Describe in detail the manner in which the well was plugged, indicating where the mud fluid was placed and the method or methods used in introducing it into the hole. If cement or other plugs were used, state the character of same and depth placed, from feet to feet for each plug set.

FILLED HOLE TO 240' WITH ROTARY MUD. PUSHED WOODEN PLUG AND 1/4 SK. HULLS TO FLUID. CEMENTED WITH 35 SKS. CEMENT.
FILLED HOLE TO 40 FEET. PUSHED WOODEN PLUG AND 1/4 SK. HULLS TO FLUID. CEMENTED WITH 15 SKS. CEMENT.
JOB COMPLETED @ 5:00 P.M. 11-11-63
TWO SKS CEMENT IN RAT HOLE.

RECEIVED
STATE CORPORATION COMMISSION

DEC 9 1963

CONSERVATION DIVISION
Wichita, Kansas

(If additional description is necessary, use BACK of this sheet)

Name of Plugging Contractor WESTERN PETROLEUM COMPANY
Address 925 PATTON ROAD, GREAT BEND, KANSAS

STATE OF KANSAS, COUNTY OF BARTON, ss.
JOHN H. VOLOSIN (employee of owner) or (~~OWNER~~) of the above-described well, being first duly sworn on oath, says: That I have knowledge of the facts, statements, and matters herein contained and the log of the above-described well as filed and that the same are true and correct. So help me God.

(Signature) John H. Volosin
925 PATTON ROAD, GREAT BEND, KANSAS (Address)

SUBSCRIBED AND SWORN TO before me this 6TH day of DECEMBER, 1963

My commission expires SEPTEMBER 15, 1965 ROMA LINK Notary Public.

DRILLER'S LOG
J. W. RILEY #1

CASING RECORD: 8 JTS 10-3/4" 32.75# CASING	COMPANY: CONTINENTAL OIL COMPANY - GEORGE A. CARLSON
TOTAL DEPTH: 4350'	CONTRACTOR: WESTERN PETROLEUM CO., INC.
	COMMENCED: OCTOBER 24, 1963
	COMPLETED: NOVEMBER 11, 1963
	ELEVATION: 1839 KB
	DESCRIPTION: SE SE SE SECTION 32-T25S-R11W STAFFORD COUNTY, KANSAS

<u>FORMATION</u>	<u>FROM</u>	<u>TO</u>	<u>REMARKS</u>
CLAY	0	30	SPUDDED 10/24/63 @ 5:00 P.M. RAN 8 JTS OF 10-3/4", 32.75# PIPE. (249.34' OVERALL). SET @ 248' CEMENTED WITH 250 SXS COMMON CEMENT, 2% GEL. PLUG DOWN @ 7:15 A.M. 10/25/63. CEMENT CIRCULATED.
SAND	30	95	
SAND, SHALE	95	115	DST #1 - 2180-2395'. OPEN 30 MIN. RECOVERED 960' MUDDY WATER. NO SHOW OF GAS. IHMP 1158#, FHMP 1138#, ISIP 761/30 MIN.; IFP 77#, FFP 501#, FSIP 741/30 MIN.
RED BED	115	550	
ANHYDRITE	550	575	DST #2 - 3988-4015. OPEN 1 HOUR. FAIR BLOW DECREASED TO WEAK. RECOVERED 60' MUD, FEW SPECKS OIL. IBHP 106#/30 MIN.; FBHP 86#/60 MIN.; IFP 19#, FFP 28#; HH2146#.
SHALE, SHELLS	575	1620	
LIME AND SHALE	1620	1777	DST #3 - 4123-4136. OPEN 45 MIN. FAIR BLOW THROUGHOUT TEST. RECOVERED 70' SLIGHTLY GASSY OIL STAINED MUD. ISIP 304#/30 MIN.; FSIP 294#/45 MIN. IFP 19#, FFP 28#, HH 2238#.
LIME	1777	2140	
LIME AND SHALE	2140	2725	DST #4 - 4301-4350. OPEN 30 MIN. STRONG BLOW DECREASING TO FAIR. RECOVERED 3105' WATER. IBHP 1491#, FBHP 1491 #/30 MIN. IFP 28#, FFP 1403#, HH 2346#.
SHALE AND LIME	2725	2820	
LIME AND SHALE	2820	2915	DST #5 - 3730-3738. OPEN 30 MIN. RECOVERED 990' MUD. IBHP 1422#, FBHP 1412#/30 MIN. IFP 57#, FFP 529#, HH 2046#. BOTTOM PACKER LEAKED, MISRUN.
LIME, CHALK, SHALE	2915	3015	
LIME AND SHALE	3015	3397	RAN GAMMA - RAY NEUTRON LATEROLOG, INTEGRATED SONIC LOG, SEISMIC REFERENCE SURVEY.
SHALE AND LIME	3397	3505	
LIME	3505	3995	D AND A - 11/11/63.
LIME AND CHERT	3995	4015	
LIME AND SHALE	4015	4136	
LIME AND CHERT	4136	4184	
CHERT AND LIME	4184	4213	
LIME, CHERT, SHALE	4213	4285	
LIME AND SHALE	4285	4341	
LIME, SAND AND SHALE	4341	4350	
RTD	4350		

ELECTRIC LOG TOPS

ANHYDRITE		
HEEBNER	3380	(-1541)
LANSING	3587	-1748
BKC	3904	-2065
CONGLOMERATE	3966	-2127
MISSISSIPPIAN	3986	-2147
KIND	4042	-2203
VIOLA	4125	-2286
SIMPSON	4225	-2386
ARBUCKLE	4290	-2451
RTD	4350	-2511

STATE OF KANSAS)
COUNTY OF BARTON)) SS

I, THE UNDERSIGNED, BEING DULY SWORN ON OATH, STATE THAT THE ABOVE STATEMENT AND LOG ARE TRUE AND A CORRECT RECORD AND LOG OF THE WELL DRILLED AT THE LOCATION ABOVE DESCRIBED.

WESTERN PETROLEUM CO., INC.

F. L. Copeland
F. L. COPELAND, DRILLING SUPT.

SUBSCRIBED AND SWORN TO BEFORE ME THIS 25TH DAY OF NOVEMBER, 1963.

Reva C. Brown
REVA C. BROWN, NOTARY PUBLIC

MY COMMISSION EXPIRES JANUARY 15, 1967.

177111


RECEIVED
STATE CORPORATION COMMISSION
DEC 2 1963
CONSERVATION DIVISION
Wichita, Kansas



