

STATE OF KANSAS  
STATE CORPORATION COMMISSION

WELL PLUGGING RECORD


OR

FORMATION PLUGGING RECORD

Strike out upper line  
when reporting plugging  
off formations.

Give All Information Completely  
Make Required Affidavit  
Mail or Deliver Report to:  
Conservation Division  
State Corporation Commission  
800 Biting Building  
Wichita, Kansas

NORTH

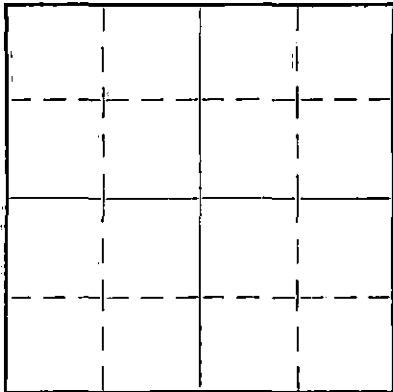

Locate well correctly on above  
Section Plat

Stafford County. Sec. 3 Twp. 25 Rge. (E) 11(W)

Location as "NE 1/4 NW 1/4 SW 1/4" or footage from lines.

Lease Owner Pryor & Lockhart, Inc.

Lease Name De Selms Well No. 1

Office Address 820 Union Natl. Bld. Wichita, Kansas

Character of Well (Completed as Oil, Gas or Dry Hole) Dry Hole

Date, well completed April 5 1938

Application for plugging filed " 5 1938

Application for plugging approved " 5 1938

Plugging Commenced " 5 1938

Plugging Completed " 6 1938

Reason for abandonment of well or producing formation Dry Hole

If a producing well is abandoned, date of last production 193

Was permission obtained from the Conservation Division or its agents before plugging was commenced? Yes

Name of Conservation Agent who supervised plugging of this well Ed Shiel

Producing formation Depth to top Bottom Total Depth of Well 4100 Feet.

Show depth and thickness of all water, oil and gas formations.

OIL, GAS OR WATER RECORDS

CASING RECORD

Formation	Content	From	To	Size	Put In	Pulled Out
Surface				13" O.D.	242'	None

Describe in detail the manner in which the well was plugged, indicating where the mud fluid was placed and the method or methods used in introducing it into the hole. If cement or other plugs were used, state the character of same and depth placed, from \_\_\_\_\_ feet to \_\_\_\_\_ feet for each plug set.

Hole filled with torary mud, hole bridged at 242' or bottom of surface pipe & cemented with 15 sax. Run other plug 10' from top and filled to top with cement

(If additional description is necessary, use BACK of this sheet)

Correspondence regarding this well should be addressed to Pryor & Lockhart, Inc.  
Address 820 Union Natl. Bank Bldg.  
Wichita, Kansas

STATE OF KANSAS, COUNTY OF SEDGWICK, ss.

T. P. Hendrick (employee of owner) of the above-described well, being first duly sworn on oath, says: That I have knowledge of the facts, statements, and matters herein contained and the log of the above-described well as filed and that the same are true and correct. So help me God.

(Signature) T. P. Hendrick

820 Union Natl. Bank Bldg., Wichita, Kansas  
(Address)

SUBSCRIBED AND SWORN to before me this 12 day of April, 1938

My commission expires Oct. 5, 1938

Notary Public.

WELL LOG BUREAU - KANSAS GEOLOGICAL SOCIETY.  
412 Union National Bank Bldg, Wichita, Kansas.

FRYOR & LOCKHART, INC.  
DeSels No. 1.

SEC. 3 T. 25 R. 11W.  
NEc NE

Total Depth. 4100  
Comm. 3-11-38 Comp. 4-7-38  
Shot or Treated.  
Contractor. Fryor and Lockhart, Inc.  
Issued. 4-16-38

County Stafford.



CASING.

133/8" 242'

Elevation.

Production. DRY.

Figures Indicate Bottom of Formations.

cellar	6	lime	3290
surface sand	35	lime and shale	3305
gravel	42	lime	3335
sand	95	shale and lime	3370
red rock	225	shale and shells	3395
shale and shells	244	lime and shale	3416
shale blue	369	lime	3722
red rock	508	lime and shale breaks	3729
anhydrite	535	chert and shale and	
shale	660	shells	3753
shale and shells	1050	chert and lime	3765
salt and shale	1300	shale and chert	3775
shale and shells	1516	chert and conglomerate	3804
lime	1575	chert and shale	3815
lime and shale breaks	1591	shale	3860
broken lime shale	1675	Viola lime	3882
lime and chert	1736	lime streaks chert	3895
lime blk	1760	lime chert	3950
lime and shale	1823	lime	3960
shale	1845	shale and lime	3979
lime soft	1890	sand	3987
sand and lime	1910	sand and shells	3995
broken lime	1989	shale sdy	4009
lime	2005	lime	4013
shale blue	2015	sand	4015
lime	2031	shale	4028
broken lime and shale	2050	lime pyrite	4033
lime and shale	2092	shale	4039
broken lime	2162	lime	4100
lime	2180		
lime and red rock	2195	Total Depth.	
lime	2265		
shale	2285	Tops From Samples.	
shale and shells	2320	Top Anhydrite	503
shale	2357	Top Ft. Riley	1780
shale and shells	2405	Top Topeka	2910
lime	2420	Top Lansing K.C.	3418
shale and shells	2439	Base Penn. Top Kinderhook	
lime	2460	shale	3785
shale	2515	Top Misonor sand	3855
lime	2525	Top Viola lime	3860
shale	2550	Top Simpson	3955
shale and shells	2590	Top Siliceous lime	4045
lime	2620		
broken lime	2630		
lime	2645		
broken lime and shale	2700		
shale and shells	2763		
lime and shale	2807		
lime hard	2810		
lime	2818		
shale and shells	2905		
lime	3012		
lime hard	3040		
broken lime	3060		
lime hard	3072		
lime	3135		
lime soft	3205		