


STATE OF KANSAS  
STATE CORPORATION COMMISSION

WELL PLUGGING RECORD

Give All Information Completely  
Make Required Affidavit  
Mail or Deliver Report to:  
Conservation Division  
State Corporation Commission  
800 Bitting Building  
Wichita, Kansas

Stafford County, Sec. 9 Twp. 25 Rge. 11W (E) (W)

NORTH

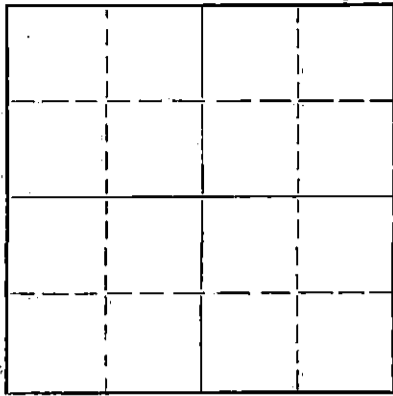

Locate well correctly on above  
Section Plat

Location as "NE/CNW/SW" or footage from lines NE NE NE  
Lease Owner Cooperative Refinery Association  
Lease Name Baar Well No. 1  
Office Address Box 766, Great Bend, Kansas  
Character of Well (completed as Oil, Gas or Dry Hole) Dry Hole (TA)  
Date well completed 4-25 1953  
Application for plugging filed 4-14 1953  
Application for plugging approved 4-17 1953  
Plugging commenced 4-25 1953  
Plugging completed 4-25 1953  
Reason for abandonment of well or producing formation Dry Hole

If a producing well is abandoned, date of last production 19  
Was permission obtained from the Conservation Division or its agents before plugging was commenced? Yes

Name of Conservation Agent who supervised plugging of this well Rives - Pratt, Kansas  
Producing formation \_\_\_\_\_ Depth to top \_\_\_\_\_ Bottom \_\_\_\_\_ Total Depth of Well 4122 Feet  
Show depth and thickness of all water, oil and gas formations.

OIL, GAS OR WATER RECORDS

CASING RECORD

FORMATION	CONTENT	FROM	TO	SIZE	PUT IN	PULLED OUT
				8 5/8	326'	
					w/ 250	
					sx. cement	

Describe in detail the manner in which the well was plugged, indicating where the mud fluid was placed and the method or methods used in introducing it into the hole. If cement or other plugs were used, state the character of same and depth placed, from \_\_\_\_\_ feet to \_\_\_\_\_ feet for each plug set.

Filled hole w/ sand from 3548 - 3465', dumped 5 sx cement. Mudded to 250', set 15' rock bridge w/ 20 sx cement on top of bridge. Mud to 35', set 5' rock bridge, dumped 10 sx cement on top for cap.


(If additional description is necessary, use BACK of this sheet)  
Name of Plugging Contractor Betts Oil Field Service  
Address Russell, Kansas

STATE OF Kansas, COUNTY OF Barton, ss.  
(employee of owner) or (owner or operator) of the above-described well, being first duly sworn on oath, says: That I have knowledge of the facts, statements, and matters herein contained and the log of the above-described well as filed and that the same are true and correct. So help me God.

(Signature) L M Collins  
Art. Bend, Kansas  
(Address)

SUBSCRIBED AND SWORN to before me this 11 day of May, 1953.

My commission expires 2-20-53  
Chas E. Endicott  
Notary Public.

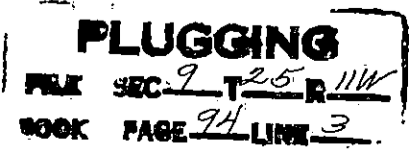

DRILLERS LOG

BAAR "A" #1

Loc: NE-NE-NE  
 Sec: 9-25-11  
 Stafford County, Kansas  
 Operator: Cooperative Refinery Ass'n.  
 Contractor: Schafer Drilling Co.

Elevation: 1801' D.F.  
 Casing: 8 5/8 @ 326' w/ 250 sx.  
 5 1/2 @ 4024.26' w/ 200 sx.  
 Comm: 2-2-53 Comp: 3-17-53  
 Total Depth: 4122'

From	To	Formation
0	125'	Sand
125	300'	Red Bed
300	325'	Cement
325	550'	Red Bed
550	575'	Anhydrite
575	1570'	Shale & Shells
1570	1845'	Lime & Shale
1845	1930'	Lime
1930	2490'	Lime & Shale
2490	2685'	Shale
2685	3015'	Lime & Shale
3015	3215'	Lime
3215	3420'	Shale & Lime
3420	3707'	Lime
3707	3747'	Lime & Shale
3747	3815'	Lime & Chert
3815	3920'	Lime & Shale
3920	3940'	Lime & Shale
3940	3976'	Lime & Chert
3976	4007'	Cherty Lime & Shale
4007	4035'	Lime & Shale
4035	4065'	Lime
4065	4102'	Lime & Shale
4102	4125'	Lime

(STATE OF KANSAS)  
 (COUNTY OF BARTON)

I hereby certify that the above is a true and correct copy of the log on the Baar "A" #1 well, located NE-NE-NE of Section 9-25-11, Stafford County, Kansas.

L. M. Collins

Subscribed and sworn to before me this 28 day of April 1953.

Elyde E. Eudicott

My commission expires: 2-20-57

**PLUGGING**  
 FILE SEC 9 T 25 R 11 W  
 BOOK PAGE 24 LINE 3

REC'D  
 STATE CONSERVATION DIVISION  
 APR 30 1953  
 CONSERVATION DIVISION  
 Wichita, Kansas