


STATE OF KANSAS  
STATE CORPORATION COMMISSION  
CONSERVATION DIVISION  
P. O. BOX 17027  
WICHITA, KANSAS 67217

FORM CP-4

WELL PLUGGING RECORD

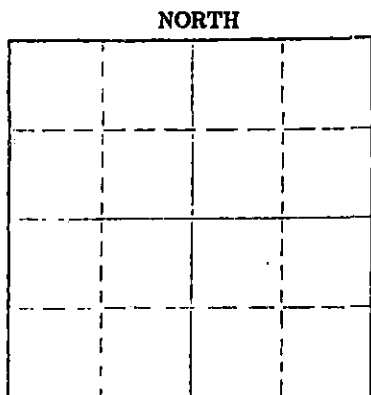

Locate well correctly on above Section Plat

Stafford County. Sec. 9 Twp. 25 Rge. 11W (E) (W)  
Location as "NE/CNW&SW&" or footage from lines SE NW SE/4  
Lease Owner Strata Search Petroleum, Inc.  
Lease Name Baar Well No. 1  
Office Address 1140 Northwest 63, Suite 300, Oklahoma City, Okla  
Character of Well (completed as Oil, Gas or Dry Hole) Dry Hole  
Date well completed March 17 19 76  
Application for plugging filed March 17 19 76  
Application for plugging approved March 17 19 76  
Plugging commenced March 17 19 76  
Plugging completed March 17 19 76  
Reason for abandonment of well or producing formation Dry Hole

If a producing well is abandoned, date of last production 19  
Was permission obtained from the Conservation Division or its agents before plugging was commenced? yes

Name of Conservation Agent who supervised plugging of this well G. R. Bieberstein  
Producing formation \_\_\_\_\_ Depth to top \_\_\_\_\_ Bottom \_\_\_\_\_ Total Depth of Well 3950 Feet  
Show depth and thickness of all water, oil and gas formations.

OIL, GAS OR WATER RECORDS

CASING RECORD

FORMATION	CONTENT	FROM	TO	SIZE	PUT IN	PULLED OUT

Describe in detail the manner in which the well was plugged, indicating where the mud fluid was placed and the method or methods used in introducing it into the hole. If cement or other plugs were used, state the character of same and depth placed, from \_\_\_\_\_ feet to \_\_\_\_\_ feet for each plug set.

Hole full heavy mud to 250' w/35 sacks cement thru drill pipe.  
Mud to 40' w/1/2 sack hulls plug, good bridge, and 10 sacks cement.  
2 sacks in rat hole.

(If additional description is necessary, use BACK of this sheet)  
Name of Plugging Contractor Duke Drilling Co.  
Address Box 823, Great Bend, Kansas 67530

STATE OF KANSAS COUNTY OF BARTON  
Larry Curtis (employee of owner) or (XXXXXXXXXXXX) of the above-described

well, being first duly sworn on oath, says: That I have knowledge of the facts, statements, and matters herein contained and the log of the above-described well as filed and that the same are true and correct. So help me God.

(Signature) Larry Curtis  
Box 823, Great Bend, Kansas (Address)

SUBSCRIBED AND SWORN TO before me this 18th day of March 19 76

My commission expires April 11, 1978  
Dorothy M. Hague Notary Public.

RECEIVED  
STATE CORPORATION COMMISSION

MAR 19 1976

CONSERVATION DIVISION  
Wichita, Kansas

DRILLERS' WELL LOG

DATE COMMENCED: March 8, 1976  
 DATE COMPLETED: March 17, 1976

Strata Search Petroleum, Inc.  
 BAAR # 1  
 SE NW SE/4  
 Sec 9-T25-RL1W  
 Stafford County, Kansas

ELEVATION: 1803 K.B.

0 - 290' Sand, Clay  
 290 - 559' Red Bed  
 559 - 568' Anhydrite  
 568 - 1442' Shale  
 1442 - 2838' Lime and Shale  
 2838 - 3254' Lime  
 3254 - 3258' Shale  
 3258 - 3284' Lime and Shale  
 3284 - 3320' Shale  
 3320 - 3418' Sand  
 3418 - 3445' Lime and Shale  
 3445 - 3688' Lime  
 3688 - 3756' Lime and Shale  
 3756 - 3832' Chert and Lime  
 3832 - 3922' Shale  
 3922 - 3950' Chert  
 3950' RTD

FORMATION TOPS

Anhydrite	559
Howard	2838
Topeka	2948
Heebner	3254
Douglas	3284
Douglas Sand	3320
Brown Lime	3418
Kansas City	3445
Base K.C.	3688
Marathon	3756
Mississippi	3794
Kinderhook	3832
Viola	3922
RTD	3950

SURFACE PIPE:

Set 290' of used 8 5/8", 28#  
 pipe w/225 sacks Common, 2% Gel,  
 3% cc.

AFFIDAVIT

STATE OF KANSAS }  
 COUNTY OF BARTON } ss.

Larry Curtis, of lawful age, does swear and state that the facts and statements herein contained are true and correct to the best of his knowledge.

Larry Curtis

Subscribed and sworn to before me this 18th day of March, 1976.

Donald M. Naugle  
 Notary Public

My Commission Expires: April 11, 1978

RECEIVED  
 STATE CONSERVATION COMMISSION

MAR 19 1976

CONSERVATION DIVISION  
 Wichita, Kansas