


STATE OF KANSAS
STATE CORPORATION COMMISSION

WELL PLUGGING RECORD

Give All Information Completely
Make Required Affidavit
Mail or Deliver Report to:
Conservation Division
State Corporation Commission
211 No. Broadway
Wichita, Kansas

Range 22 County 26S Twp. 6N Rge. 6W (E) 6W

NORTH

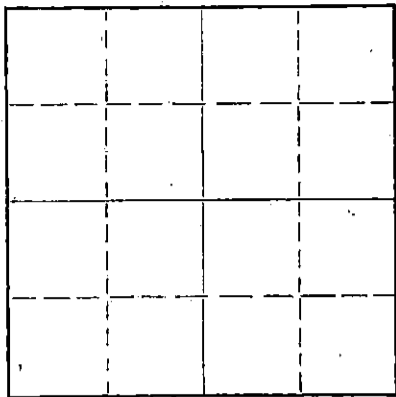

Locate well correctly on above
Section Plat

Location as "NE/CNW/SE" or footage from lines NE 1/4 22
Lease Owner Shawver-Armour, Inc.
Lease Name Ed P. Graber Well No. 1
Office Address 817 Central Building, Wichita, Kansas
Character of Well (completed as Oil, Gas or Dry Hole) Dry Hole
Date well completed _____ 19____
Application for plugging filed 10-6-57
Application for plugging approved 10-6-57
Plugging commenced 10-6-57
Plugging completed 10-6-57
Reason for abandonment of well or producing formation _____

If a producing well is abandoned, date of last production _____ 19____
Was permission obtained from the Conservation Division or its agents before plugging was commenced? Yes

Name of Conservation Agent who supervised plugging of this well Ruel Burkes
Producing formation Mississippi Depth to top 3739 Bottom 3724 Total Depth of Well 3724 Feet
Show depth and thickness of all water, oil and gas formations.

OIL, GAS OR WATER RECORDS

CASING RECORD

FORMATION	CONTENT	FROM	TO	SIZE	PUT IN	PULLED OUT
<u>Surface</u>	<u>water</u>	<u>0</u>	<u>277</u>	<u>5/8</u>	<u>277</u>	<u>none</u>

Describe in detail the manner in which the well was plugged, indicating where the mud fluid was placed and the method or methods used in introducing it into the hole. If cement or other plugs were used, state the character of same and depth placed, from _____ feet to _____ feet for each plug set.

Gun pits bring heavy mud around, layed down drill pipe, then heavy mud to 225'

#1 plug # 225' Halliburton plug 1/2 in holes 15 in cement thru drill pipe then, heavy mud to 20'

#2 plug 20' Halliburton plug 1/2 in holes 5 in cement to base of casing

(If additional description is necessary, use BACK of this sheet)

Name of Plugging Contractor Shawver-Armour, Inc.
Address 817 Central Building, Wichita, Kansas

STATE OF KANSAS, COUNTY OF _____, ss.

JAMES ARMOUR (employee of owner) or (owner or operator) of the above-described well, being first duly sworn on oath, says: That I have knowledge of the facts, statements, and matters herein contained and the log of the above-described well as filed and that the same are true and correct. So help me God.

(Signature) James Armour
JAMES ARMOUR 817 Central Building
(Address)

SUBSCRIBED AND SWORN TO before me this 6 day of October, 1957

Marjorie Hall Notary Public.

My commission expires December 29, 1959

MARJORIE HALL, RECEIVED
STATE CORPORATION COMMISSION

PLUGGING
FILE SEC...22 T. 26 R. 6W
BOOK PAGE...53 LINE 16

OCT 12 1957
10-12-57
CONSERVATION DIVISION

DRILLING LOG

COMPANY: SHAWVER-ARMOUR, INC.

LOCATION: NE NE NW Section 22-26S-6W
Reno, County, Kansas

CONTRACTOR: SHAWVER-ARMOUR, INC.

FARM NAME: ED P. GRABER NO. 1

ELEVATION: 1563 KB

COMMENCED: September 25, 1957

COMPLETED: October 6, 1957

CASING RECORD: 277' 8 5/8" 200' sx 2%cc

FORMATION

TOPS

SURFACE CLAY AND SAND	40
CLAY BLUE SHALE & RED ROCK	90
SHALE	640
SALT & SHALE	805
SHALE AND ANHYDRITE	1100
SHALE & LIME	1135
LIME & SHALE	1535
SHALE & LIME	2165
SHALE & LIME SHELLS	2360
SHALE & LIME	2615
LIME & SHALE	2945
SHALE & LIME	3015
LIME	3145
KANSAS CITY LIME	3211
LIME & SHALE	3393
LIME	3435
LIME & SHALE	3487
SHALE & LIME	3708
MISSISSIPPIAN	3724 RTD.

HEEBNER	2739	(-1176)
BROWN LIME	2996	(-1433)
LANSING	3008	(-1445)
MISSISSIPPIAN	3709	(-2146)

STATE OF KANSAS)
) SS.
SEDGWICK COUNTY)

I, James Armour, do hereby certify that the above is a true and correct copy of the log on the above captioned well, as shown on the daily drilling reports.

SHAWVER-ARMOUR, INC.

BY James Armour
JAMES ARMOUR

Marjorie Hall
MARJORIE HALL, NOTARY PUBLIC

Subscribed and sworn to before me this
6th day of October, 1957
My commission expires December 29, 1959

PLUGGING
FILE SEC 22 T. 26 R. 6W
BOOK PAGE 53 LINE 16

RECEIVED
STATE CORPORATION COMMISSION

OCT 12 1957

10-12-57
VISION