

# WELL PLUGGING RECORD

STATE OF KANSAS  
STATE CORPORATION COMMISSION

Give All Information Completely  
Make Required Affidavit  
Mail or Deliver Report to:  
Conservation Division  
State Corporation Commission  
800 Bittling Building  
Wichita, Kansas

## FORMATION PLUGGING RECORD

Strike out upper line  
when reporting plug-  
ging off formations.

Reno County. Sec. 15 Twp 26 Rge 6 (E) E (W)

Location as "NE $\frac{1}{4}$ NW $\frac{1}{4}$ SW $\frac{1}{4}$ " or footage from lines. SE/Corner of SE/4

Lease Owner. Lion Oil Company

Lease Name. Schwartz Well No. #1

Office Address. Box 552 Pratt, Kansas

Character of Well (completed as Oil, Gas or Dry Hole) Dry Hole

Date well completed 7-21-48 19

Application for plugging filed 3-15-49 19

Application for plugging approved 3-15-49 19


Plugging commenced 3-15-49 19

Plugging completed 3-15-49 19

Reason for abandonment of well or producing formation Dry Hole

If a producing well is abandoned, date of last production 19

Was permission obtained from the Conservation Division or its agents before plugging was com-  
menced? Yes

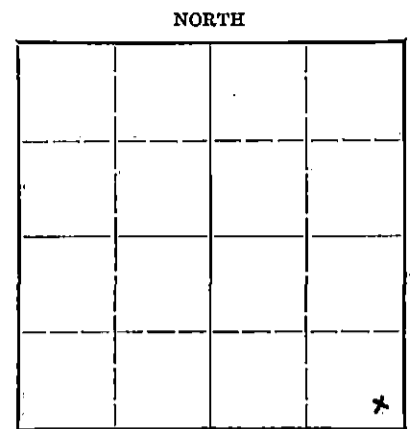

Locate well correctly on above  
Section Plat

Name of Conservation Agent who supervised plugging of this well Mr. Ruel Durkee

Producing formation Depth to top Bottom Total Depth of Well 3683' Feet

Show depth and thickness of all water, oil and gas formations.

### OIL, GAS OR WATER RECORDS CASING RECORD

Formation	Content	From	To	Size	Put In	Pulled Out
				8 5/8"	281'	
				5 1/2"	3660'	2711'

Describe in detail the manner in which the well was plugged, indicating where the mud fluid was placed and the method or methods used in introducing it into the hold. If cement or other plugs were used, state the character of same and depth placed, from feet to feet for each plug set.

Mud to 3250' Ran 6 sacks cement  
Mud to 275' Set plug with 15 sacks of cement  
Mud to 15' Set plug with 5 sacks of cement

RECEIVED

3-22-49  
MAR 22 1949

(If additional description is necessary, use BACK of this sheet)  
Correspondence regarding this well should be addressed to Lion Oil Company STATE  
Address Box 552 Pratt, Kansas

STATE OF Kansas COUNTY OF Pratt, ss.

Vernon Hayes (employee of owner) or (owner or operator) of the above-described well,  
being first duly sworn on oath, says: That I have knowledge of the facts, statements, and matters herein contained and the log of the above-  
described well as filed and that the same are true and correct. So help me God.

(Signature) Vernon Hayes

(Address)

SUBSCRIBED AND SWORN TO before me this 21st day of March 1949  
Patricia Hennig  
Notary Public

My commission expires with office 22-237 7-47-10M

PLUGGING  
FILE SEC 15T 26R 6W  
BOOK PAGE 27 LINE 39

Lion Oil Company  
El Dorado, -Arkansas

Schwartz No. 1

SE SE SE  
Sec. 15-26-6W  
Reno County, Kansas

Contractor: The R. W. Rine Drilling Company  
Started: 7-2-48 Finished: 7-13-48

Log

Surface, red bed, shale	0- 281	8 5/8" cemented @ 281'
Shale, shells, sand	281- 960	
Anhydrite	960-1300	
Lime, shale	1300-1830	
Shale, shells	1830-2065	
Shale, shells, lime	2065-2250	
Lime, shale	2250-3050	
Lime	3050-3240	
Lime, shale	3240-3470	
Lime, shale, shells	3470-3540	
Lime, shale	3540-3663	5 1/2" cemented @ 3660'

Total Depth: 3663'

State of Kansas ) ss  
County of Sedgwick)

I, E. H. Sloyer, do hereby certify that the above is a true and complete log of the Schwartz No. 1 well located in the SE/4 of the SE/4 of the SE/4 of Sec. 15-26-6W, Reno County, Kansas.

*E. H. Sloyer*

Assistant Secretary

Sworn to and subscribed before me this 3rd day of August, 1948.

*Roneta Harvey*

My Commission Expires August 27, 1951

RECORDED  
3-22-49

PLUGGING  
FILE SEC 15 T 26 R 6W  
BOOK PAGE 87 LINE 39