


STATE OF KANSAS
STATE CORPORATION COMMISSION

Give All Information Completely
Make Required Affidavit
Mail or Deliver Report to:
Conservation Division
State Corporation Commission
211 No. Broadway
Wichita, Kansas

WELL PLUGGING RECORD

NORTH

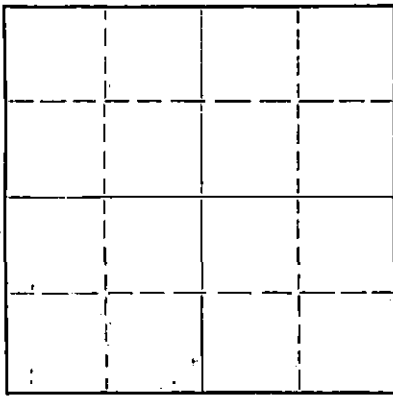

Locate well correctly on above
Section Plat

Reno County. Sec. 26 Twp. 26 Rge. 6 (E) 6 (W)
Location as "NE/CNW/SW" or footage from lines NW NW NW
Lease Owner Aylward Drilling Company
Lease Name Krehbiel Well No. _____
Office Address 813 1st Nat'l Bank Bldg. - Wichita, Kansas
Character of Well (completed as Oil, Gas or Dry Hole) Dry Hole
Date well completed March 7 1958
Application for plugging filed March 7 1958
Application for plugging approved March 7 1958
Plugging commenced March 7 1958
Plugging completed March 7 1958
Reason for abandonment of well or producing formation _____

If a producing well is abandoned, date of last production _____ 19____
Was permission obtained from the Conservation Division or its agents before plugging was commenced? Yes

Name of Conservation Agent who supervised plugging of this well Fred Hampel - Pretty Prairie, Kansas
Producing formation _____ Depth to top _____ Bottom _____ Total Depth of Well 4117 Feet
Show depth and thickness of all water, oil and gas formations.

OIL, GAS OR WATER RECORDS

CASING RECORD

FORMATION	CONTENT	FROM	TO	SIZE	PUT IN	PULLED OUT
				8 5/8"	225'	None

Describe in detail the manner in which the well was plugged, indicating where the mud fluid was placed and the method or methods used in introducing it into the hole. If cement or other plugs were used, state the character of same and depth placed, from _____ feet to _____ feet for each plug set.

Filled hole with heavy mud from total depth to 200'; cement plug with 15 sacks of cement from 200' to 150'; heavy mud to 35'; cement plug with 10 sacks of cement from 35' to top of surface pipe.

(If additional description is necessary, use BACK of this sheet)
Name of Plugging Contractor Aylward Drilling Company
Address 813 First National Bank Bldg. - Wichita, Kansas

STATE OF Kansas, COUNTY OF Sedgwick, ss.
Paul W. Hesse (employee of owner) or (owner or operator) of the above-described

well, being first duly sworn on oath, says: That I have knowledge of the facts, statements, and matters herein contained and the log of the above-described well as filed and that the same are true and correct. So help me God.

(Signature)


813 1st Nat'l Bank Bldg., Wichita, Kansas
(Address)

SUBSCRIBED AND SWORN to before me this 10th day of March, 1958

My commission expires December 11, 1961

DUANE JESSUP

Notary Public.

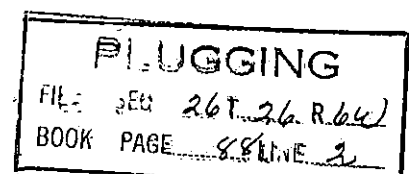

KREHBIEL NO. 1

Casing Record:

Company: Aylward Drilling Company et al
Contractor: Aylward Drilling Company

Location: NW NW NW 26-26-6W
Reno County, Kansas

8 5/8" - 225'

Commenced: February 21, 1958
Completed: March 7, 1958

Elevation: 1570 D.F.

	From	To	Remarks
Clay and Sand	0	40	Set 8 5/8" Surface Pipe @ 225' w/165 sax cement.
Sand	40	90	
Red Rock	90	225	
Red Rock and Shale	225	700	Geological Tops:
Shale and Shells	700	830	
Anhydrite and Lime	830	1055	Heebner Shale 2741
Lime and Shale	1055	1725	Base/Oread 2768
Shale and Lime	1725	2040	Douglas Sand 2815
Shale with Lime Streaks	2040	2240	Tonganoxie Sand 2988
Lime and Shale	2240	2770	Lansing 3011
Sandy Shale	2770	2864	Base/Kansas City 3452
Sand and Shale	2864	3005	Mississippian 3716
Lime with some Shale	3005	3043	Kinderhook Shale 3923
Lime	3043	3482	Viola 4086
Lime with Shale	3482	3530	Simpson Sand 4098
Lime and Shale	3530	3670	R.T.D. 4117
Lime with Shale	3670	3724	
Lime	3724	3784	
Cherty Lime	3784	3886	DST 3718-24 Open 1 1/2 hr. Gas to surf. in 4 min. (not gaugeable). Rec. 30'
Lime and Shale	3886	4022	gassy mud. IFP 110# - FFP 80#
Shale and Lime	4022	4064	IBHP 1400#/20" - FBHP 1340#/20"
Lime	4064	4117 T.D.	

DST 3724-34 Open 1 1/2 hr. Good blow dim.
to weak. Rec. 150' muddy SW.
FP 0#-70#. IBHP failed. FBHP 910#/20"
D. & A.

I hereby certify that this is a true and correct copy of the above log to the best of my knowledge.

Paul W. Hesse

Subscribed and sworn to before me this 12th day of March, 1958.

Duane Jessup
DUANE JESSUP Notary Public

My commission expires December 11, 1961.

PLUGGING
FILE SEC. 26T 26R 6W
BOOK PAGE 88 LINE 2

STATE CORP. 3-21-58
MAR 21 1958
CONCESSION DIVISION
Wichita, Kansas