

STATE OF KANSAS  
STATE CORPORATION COMMISSION

WELL PLUGGING RECORD

Give All Information Completely  
Make Required Affidavit  
Mail or Deliver Report to  
Conservation Division  
State Corporation Comm.  
245 North Water  
Wichita, KS 67202

Reno County. Sec. 15 Twp. 26S Rge. 8 NE/SW  
Location as "NE/CNW $\frac{1}{2}$ SW $\frac{1}{2}$ " or footage from lines

NE SW SW  
Lease Owner Price Exploration Co.  
Lease Name Kelloqq Well No. #1


Office Address 814 Mayo Bldg., Tulsa, Okla. 74103  
Character of Well (Completed as Oil, Gas or Dry Hole)

Dry Hole  
Date Well completed 11-3-78 19  
Application for plugging filed 11-3-78 19  
Application for plugging approved 11-3-78 19  
Plugging commenced 11-3-78 19  
Plugging completed 11-3-78 19

Reason for abandonment of well or producing formation  
Commercial quantities of oil not found  
If a producing well is abandoned, date of last production 19

Was permission obtained from the Conservation Division or  
its agents before plugging was commenced? Yes

Name of Conservation Agent who supervised plugging of this well Gilbert Toman  
Producing formation \_\_\_\_\_ Depth to top \_\_\_\_\_ Bottom \_\_\_\_\_ Total Depth of Well 4000'  
Show depth and thickness of all water, oil and gas formations.

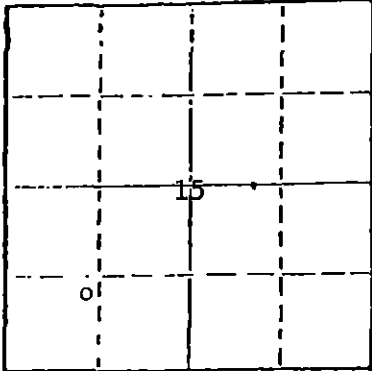

Locate well correctly on above  
Section Plat

OIL, GAS OR WATER RECORDS

CASING RECORD

FORMATION	CONTENT	FROM	TO	SIZE	PUT IN	PULLED OUT
				8 5/8"	241'	None

Describe in detail the manner in which the well was plugged, indicating where the mud fluid was placed and the method or methods used in introducing it into the hold. If cement or other plugs were used, state the character of same and depth placed, from \_\_\_\_\_ feet to \_\_\_\_\_ feet for each plug set.

Plug @ 500' w/40 sx.  
Plug @ 230' w/25 sx.  
Plug @ 40' w/10 sx.  
Rat Hole 3 sx.

STATE RECEIVED  
STATE CORPORATION COMMISSION  
TSC 1 12-11-78  
CONSERVATION DIVISION  
Wichita, Kansas

(If additional description is necessary, use BACK of this sheet)  
Name of Plugging Contractor Rains & Williamson Oil Co., Inc.

STATE OF Kansas COUNTY OF Sedgwick, ss.  
Wilson Rains, President of Rains & Williamson Oil Co., Inc. (employee of owner) or (owner or operator) of the above-described well, being first duly sworn on oath, says: That I have knowledge of the facts, statements, and matters herein contained and the log of the above-described well as filed and that the same are true and correct. So help me God.

(Signature) Wilson Rains  
435 Page Court, 220 W. Douglas, Wichita, Ks. 67202  
(Address)

SUBSCRIBED AND SWORN TO before me this 7 day of November, 1978



Juanita M. Green  
Notary Public.

DRILLER'S LOG

COMPANY: Price Exploration Co.

SEC. 15 T. 26S R. 8W

WELL NAME: Kellogg #1

LOC. NE SW SW

COUNTY: Reno

RIG NO. #3

TOTAL DEPTH 4000'

ELEVATION

COMMENCED: 10-25-78

COMPLETED: 11-3-78

CONTRACTOR: Rains & Williamson Oil Co., Inc.

CASING RECORD:

SURFACE: 8 5/8" @ 241' w/125 sx. common, 2% gel, 3% cc.

PRODUCTION: D&A

LOG

(Figures Indicate Bottom of Formations)


Redbed	703
Shale	1415
Shale & Lime	1443
Shale	2345
Lime & Shale	2519
Shale	3046
Shale & Lime	3367
Lime	4000
<u>ROTARY TOTAL DEPTH</u>	<u>4000</u>

RECEIVED  
STATE CORPORATION COMMISSION  
DEC 11 1978  
CONSERVATION DIVISION  
Wichita, Kansas  
12-11-78

STATE OF Kansas )  
COUNTY OF Sedgwick ) SS:

I, Wilson Rains, President of Rains & Williamson Oil Co., Inc.  
upon oath state that the above and foregoing is a true and correct copy of the log of the  
Kellogg #1 well.

Wilson Rains  
Wilson Rains

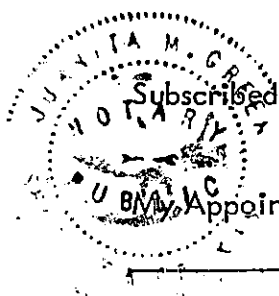

Subscribed and sworn to before me this 7 day of November, 1978.

Appointment Expires:  
10-4-79

Juanita M. Green  
Juanita M. Green