


STATE OF KANSAS
STATE CORPORATION COMMISSION

Form CP-4

Give All Information Completely
Make Required Affidavit
Mail or Deliver Report to:
Conservation Division
State Corporation Commission
211 No. Broadway
Wichita, Kansas

WELL PLUGGING RECORD

NORTH

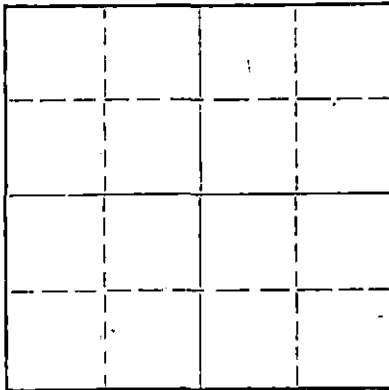Locate well correctly on above
Section Plat

Reno County, Sec. 35 Twp. 25S Rge. 5W (H) (W)
 Location as "NE/CNW/SW" or footage from lines C SE SW
 Lease Owner Leben Drilling, Inc.
 Lease Name Tonn C Well No. 1
 Office Address P. O. Box 486, Great Bend, Kansas
 Character of Well (completed as Oil, Gas or Dry Hole) Dry Hole
 Date well completed 12-19-62 19__
 Application for plugging filed 12-19-62 19__
 Application for plugging approved 12-19-62 19__
 Plugging commenced 12-19-62 19__
 Plugging completed 12-19-62 19__
 Reason for abandonment of well or producing formation Dry Hole

If a producing well is abandoned, date of last production 19__
 Was permission obtained from the Conservation Division or its agents before plugging was commenced? yes

Name of Conservation Agent who supervised plugging of this well Herman Justus, Nickerson, Kansas
 Producing formation _____ Depth to top _____ Bottom _____ Total Depth of Well 4125 Feet
 Show depth and thickness of all water, oil and gas formations.

OIL, GAS OR WATER RECORDS

CASING RECORD

FORMATION	CONTENT	FROM	TO	SIZE	PUT IN	PULLED OUT
				8 5/8"	242'	None

Describe in detail the manner in which the well was plugged, indicating where the mud fluid was placed and the method or methods used in introducing it into the hole. If cement or other plugs were used, state the character of same and depth placed, from _____ feet to _____ feet for each plug set.

Bottom plug set @ 180' with $\frac{1}{4}$ sk. hulls and 20 sks. cement.

Top plug set @ 40' with $\frac{1}{4}$ sk. hulls and 10 sks. cement.

RECEIVED
STATE CORPORATION COMMISSION

DEC 28 1962

CONSERVATION DIVISION
Wichita, Kansas

(If additional description is necessary, use BACK of this sheet)

Name of Plugging Contractor Leben Drilling, Inc.
 Address P. O. Box 486, Great Bend, Kansas

STATE OF KANSAS, COUNTY OF BARTON, ss.

Byron Johnson (employee of owner) or (owner or operator) of the above-described well, being first duly sworn on oath, says: That I have knowledge of the facts, statements, and matters herein contained and the log of the above-described well as filed and that the same are true and correct. So help me God.

(Signature)

Byron Johnson
P. O. Box 486, Great Bend, Kansas
 (Address)

SUBSCRIBED AND SWORN TO before me this 26th day of December, 19 62My commission expires April 1, 1963

Ulanda Nichols

Notary Public.



DRILLER'S LOG

COMPANY: Leben Drilling, Inc.
CONTRACTOR: LEBEN DRILLING, INC.
FARM: TONN C-#1
LOCATION: C SE SW Sec. 35-25S-5W
RENO COUNTY, KANSAS
COMMENCED: 12-6-62
COMPLETED: 12-19-62

0	45	Clay, Sand & Shells
45	150	Shale & Lime Shells
150	243	Hard Blue Shale Streaks
243	635	Shale & Shells
635	670	Anhydrite
670	830	Shale & Lime
830	1047	Lime
1047	1545	Lime & Shale
1545	2124	Shale & Shells
2124	2200	Shale & Lime
2200	2764	Lime & Shale
2764	3194	Lime
3194	3255	Lime & Shale
3255	3451	Lime
3451	3560	Lime & Shale
3560	3600	Mississippi
3600	3630	Mississippi Chert & Lime
3630	3642	Chert
3642	3668	Chert & Lime
3668	3713	Lime & Chert
3713	3740	Lime
3740	3840	Lime & Chert
3840	3993	Shale & Lime
3993	4008	Viola
4008	4031	Sand
4031	4125	Shale & Sand
	<u>4125</u>	<u>Rotary Total Depth - D. & A.</u>

RECEIVED
STATE CORPORATION COMMISSION
DEC 28 1962
CONSERVATION DIVISION
Wichita, Kansas

Set 8 5/8" used surface casing @ 242' Cemented w/210' sacks of Sunset by Sun Oilwell Cementing.


I, Byron Johnson, do hereby certify that the above and foregoing is a true and correct copy of the log of the Tonn C-#1, located C SE SW of Section 35, Township 25 South, Range 5 West, Reno County, Kansas, as reflected by the files of Leben Drilling, Inc.



Byron Johnson

STATE OF KANSAS)
COUNTY OF BARTON) SS

Subscribed and sworn to before me, a Notary Public in and for Barton County, Kansas, this 26th day of December, 1962.

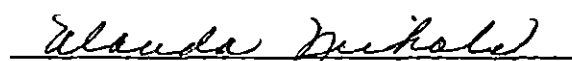

Ulanda Nichols, Notary Public

Commission Expires: April 1, 1963