


STATE OF KANSAS
STATE CORPORATION COMMISSION

WELL PLUGGING RECORD

Give All Information Completely
Make Required Affidavit
Mail or Deliver Report to
Conservation Division
State Corporation Comm.
245 North Water
Wichita, KS 67202

Stafford County. Sec. 27 Twp. 25 Rge. 13 E/W
Location as "NE/CNW $\frac{1}{4}$ SW $\frac{1}{4}$ " or footage from lines N/2-NW-SE
Lease Owner F & M Oil Company
Lease Name Gobin "A" Well No. 1
Office Address 505 Union Center, Wichita, Kansas 67202
Character of Well (Completed as Oil, Gas or Dry Hole) _____

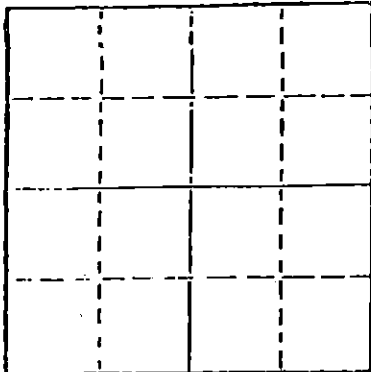

Locate well correctly on above
Section Plot

Dry Hole
Date Well completed 6-24-77 19
Application for plugging filed 6-24-77 19
Application for plugging approved 6-24-77 19
Plugging commenced 6:30 A.M. 6-24-77 19
Plugging completed 7:00 A.M. 6-24-77 19
Reason for abandonment of well or producing formation _____
dry

If a producing well is abandoned, date of last production _____ 19

Was permission obtained from the Conservation Division or its agents before plugging was commenced? yes

Name of Conservation Agent who supervised plugging of this well J. Metz
Producing formation _____ Depth to top _____ Bottom _____ Total Depth of Well 4305'
Show depth and thickness of all water, oil and gas formations.

OIL, GAS OR WATER RECORDS

CASING RECORD

FORMATION	CONTENT	FROM	TO	SIZE	PUT IN	PULLED OUT

Describe in detail the manner in which the well was plugged, indicating where the mud fluid was placed and the method or methods used in introducing it into the hold. If cement or other plugs were used, state the character of same and depth placed, from _____ feet to _____ feet for each plug set.

Bottom Plug at 280' W/35 sacks 50/50 Pozmix
Top Plug at 40' W/ 1/2 sack hulls & 10 sacks Pozmix
2 sacks in rat hole

RECEIVED
STATE CORPORATION COMMISSION

JUN 28 1977

CONSERVATION DIVISION
Wichita, Kansas

(If additional description is necessary, use BACK of this sheet)

Name of Plugging Contractor _____

STATE OF Kansas COUNTY OF Barton, ss.
Wayne Dobbs (employee of owner) or (owner or operator)
of the above-described well, being first duly sworn on oath, says: That I have knowledge of the facts, statements, and matters herein contained and the log of the above-described well as filed and that the same are true and correct. So help me God.

(Signature) Wayne Dobbs
Great Bend, Kansas

SUBSCRIBED AND SWORN TO before me this 24th day of June, 19 77

My commission expires 5-20-81

Bessie M. DeWerff
Bessie M. DeWerff Notary Public.

BESSIE M. DEWERFF
STATE NOTARY PUBLIC
BARTON COUNTY, KANSAS
MY APPT. EXP. 5-20-81

DRILLERS WELL LOG

L. D. DRILLING COMPANY - CONTRACTOR F. & M OIL COMPANY - OPERATOR

1 GOBIN "A"
N/2-NW-SE-27-25-13
STAFFORD COUNTY, KANSAS

T. D. 4305'
ELEV. 1928 KB

COMMENCED: 6-15-77
COMPLETED: 6-24-77

Casing:

8 5/8" set at 259'

Cement:

w/210 sacks 60/40 Pozmix, 2% Gel, 3%CC

FORMATION

DEPTH

Shale	0 - 40
Sand	40 - 200
Red Bed	200 - 550
Shale & Shells	550 - 1750
Lime & Shale	1750 - 3516
Shale	3516 - 3520
Lime & Shale	3520 - 4015
Cong.	4015 - 4259
Sand & Lime	4259 - 4305

TOPS

Heeb.	3516
Brn. Lime	3673
Lansing	3703
Marm.	4015
Miss.	4125
Viola	4205
Simp. Sand	4259

RECEIVED

AFFIDAVIT

STATE OF KANSAS, COUNTY OF BARTON

I, WAYNE DOBBS of the L. D. DRILLING COMPANY

being first duly sworn on oath, state: That I have knowledge of the facts, statements and matters herein contained and that the same are true and correct.

Wayne Dobbs
Wayne Dobbs

Subscribed and sworn to before me on this 27th day of June 1977

My commission expires: 5-20-81

BESSIE M. DEWERFF
STATE NOTARY PUBLIC
BARTON COUNTY, KANSAS
MY APPT. EXP. 5-20-81

Bessie M. Dewerff
Notary Public, Bessie M. Dewerff