

STATE OF KANSAS  
STATE CORPORATION COMMISSION


Give All Information Completely  
Make Required Affidavit  
Mail or Deliver Report to:  
Conservation Division  
State Corporation Commission  
800 Bittling Building  
Wichita, Kansas

WELL PLUGGING RECORD

Stafford County. Sec. 27 Twp. 25 Rge. 13 (Z)/(W)

Location as "NE/CNW/SW" or footage from lines NE NE SW  
Lease Owner Lee Phillips Oil Company  
Lease Name Gobin Well No. 1  
Office Address Union National Bank Bldg., Wichita, Kansas  
Character of Well (completed as Oil, Gas or Dry Hole) Dry Hole  
Date well completed March 9, 1956 19  
Application for plugging filed March 9, 1956 19  
Application for plugging approved March 9, 1956 19  
Plugging commenced March 9, 1956 19  
Plugging completed March 9, 1956 19  
Reason for abandonment of well or producing formation Dry Hole

NORTH

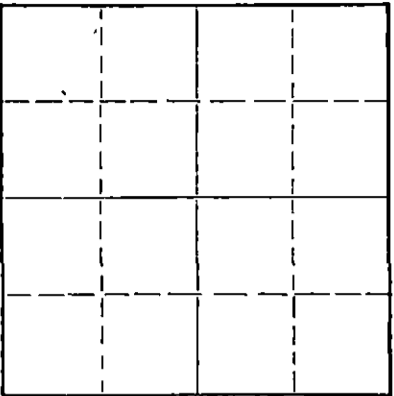

Locate well correctly on above Section Plat

If a producing well is abandoned, date of last production \_\_\_\_\_ 19\_\_\_\_  
Was permission obtained from the Conservation Division or its agents before plugging was commenced? Yes

Name of Conservation Agent who supervised plugging of this well R. M. Brundage  
Producing formation \_\_\_\_\_ Depth to top \_\_\_\_\_ Bottom \_\_\_\_\_ Total Depth of Well 4344 Feet  
Show depth and thickness of all water, oil and gas formations.

OIL, GAS OR WATER RECORDS

CASING RECORD

FORMATION	CONTENT	FROM	TO	SIZE	PUT IN	PULLED OUT
	Surface Pipe	0	363	8-5/8"	363'	None

Describe in detail the manner in which the well was plugged, indicating where the mud fluid was placed and the method or methods used in introducing it into the hole. If cement or other plugs were used, state the character of same and depth placed, from \_\_\_\_\_ feet to \_\_\_\_\_ feet for each plug set.

Filled hole with heavy mud to 300'.  
Bridged hole at 300'. Ran 25 sacks  
cement 300' up. Bridge hole at 40',  
ran 15 sacks cement. Plug 40' to  
base of cellar.

3-13-56

(If additional description is necessary, use BACK of this sheet)  
Name of Plugging Contractor Isern Drilling Company  
Address Box 45, Ellinwood, Kansas


STATE OF KANSAS, COUNTY OF BARTON, ss.  
I. M. M. Shropshire (employee of owner) or (~~owner~~/operator) of the above-described well, being first duly sworn to, says: That I have knowledge of the facts, statements, and matters herein contained and the log of the above-described well as filed and that the same are true and correct. So help me God.

(Signature) I. M. M. Shropshire  
Lyons, Kansas (Address)

SUBSCRIBED AND SWORN TO before me this 10th day of March, 19 56

My commission expires Feb. 10, 1959.

George A. Meyer  
Notary Public.

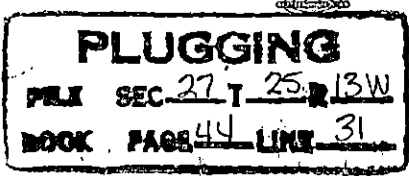

WELL LOG

Lee Phillips Oil Company, Owner - Gobin #1  
 NE/4 NE/4 SW/4 Section 27, Township 25, Range 13W,  
 Stafford County, Kansas

ELEVATION: 1924 DF

Figures indicate bottom of formation

0	to	35	shale
		185	sand
		280	shale & shells
		295	sand
		363	shale & shells
		815	shale
		1250	shale & shells
		1525	salt
		1760	shale & shells
		2186	lime & shale
		2275	shale & shells
		2650	lime & shale
		2695	shale & shells
		2845	lime & shale
		3230	shale & shells
		3890	lime & shale
		3945	lime
		4090	lime & shale
		4228	Conglomerate
		4240	lime & chert
		4288	lime, shale & chert
		4296	Simpson shale
		4344	Arbuckle
		4344	Rotary Total
			Depth D&A

PIPE RECORD:

8-5/8" set at 363'  
 Cemented with 250 sacks.  
 February 26, 1956

RECEIVED  
 STATE CORPORATION COMMISSION  
 MAR 15 1956  
 CONSERVATION DIVISION  
 Wichita, Kansas

Rotary Commenced 2-25-56  
 Completed 3-9-56

STATE OF KANSAS )  
 COUNTY OF BARTON ) ss

I, M. M. Shropshire, Drilling Superintendent of the above-described well, being first duly sworn on oath, declare: That I have knowledge of the facts, statements and matters herein contained pertaining to the log of the above-described well, as filed, and that the same are true and correct.

M. M. Shropshire

Subscribed and Sworn to before me this 12th day of March, 1956.

George A. Meyer

My commission expires Feb. 10, 1959.

PLUGGING  
 FILE SEC 27 T 25 R 13W  
 BOOK PAGE 44 LINE 31