

STATE OF KANSAS
STATE CORPORATION COMMISSION


WELL PLUGGING RECORD

Give All Information Completely
Make Required Affidavit
Mail or Deliver Report to:
Conservation Division
State Corporation Commission
800 Bitting Building
Wichita, Kansas

OR

FORMATION PLUGGING RECORD

Strike out upper line
when reporting plug-
ging of formations.

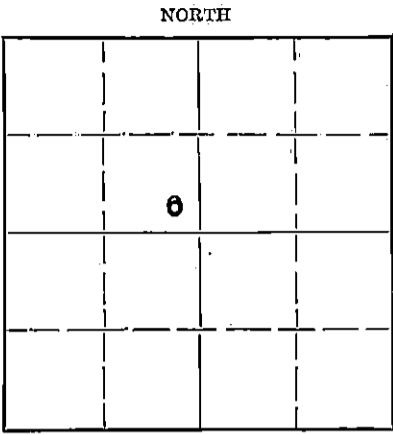

Locate well correctly on above
Section Plat

Stafford County. Sec. 1 Twp. 25S. Rge. 11 (#) (W)
Location as "NE 1/4 NW 1/4 SW 1/4" or footage from lines SE SE NW
Lease Owner Claude Wentworth Drilling Co.
Lease Name J. E. Sanders Well No. 1
Office Address Box 588 Russell, Kansas
Character of Well (completed as Oil, Gas or Dry Hole) Dry Hole
Date well completed August 16 19 54
Application for plugging filed 19
Application for plugging approved 19
Plugging commenced August 16 19 54
Plugging completed August 16 19 54
Reason for abandonment of well or producing formation Dry hole

If a producing well is abandoned, date of last production 19
Was permission obtained from the Conservation Division or its agents before plugging was com-
menced? yes

Name of Conservation Agent who supervised plugging of this well Mr. M. A. Rives
Producing formation Depth to top Bottom Total Depth of Well 4376' Feet
Show depth and thickness of all water, oil and gas formations.

OIL, GAS OR WATER RECORDS

CASING RECORD

Formation	Content	From	To	Size	Put In	Pulled Out
Surface					275'	0

Describe in detail the manner in which the well was plugged, indicating where the mud fluid was placed and the method or methods used in introducing it into the hole. If cement or other plugs were used, state the character of same and depth placed, from feet to feet for each plug set.

Hole filled with rotary mud from 4376' to 270'. Set bridging plug at 270' and pump 20 sacks cement on top of plug. Fill to 40' with rotary mud. Plug set and anchored at 40', pump 15 sacks cement on top of plug to bottom of cellar. All cement spotted by Walliburton.

(If additional description is necessary, use BACK of this sheet)

Correspondence regarding this well should be addressed to Claude Wentworth Drilling Co.
Address Box 588, Russell, Kansas

STATE OF Kansas COUNTY OF Russell, ss.

Donald R. Wentworth (employee of owner) or (owner or operator) of the above-described well, being first duly sworn on oath, says: That I have knowledge of the facts, statements, and matters herein contained and the log of the above-described well as filed and that the same are true and correct. So help me God.

(Signature) Donald R. Wentworth

Box 588, Russell, Kansas (Address)

SUBSCRIBED AND SWORN to before me this 25th day of August 1954

My commission expires 8-23-54

22-2625 2-48-15M

PLUGGING
FILE SEC. LY 25 R 14W
BOOK PAGE 57 UNK 14

RECEIVED
STATE CORPORATION COMMISSION
Notary Public.

AUG 26 1954

CONSERVATION DIVISION
Wichita, Kansas