


STATE OF KANSAS
STATE CORPORATION COMMISSION
Give All Information Completely
Make Required Affidavit
Mail or Deliver Report to:
Conservation Division
State Corporation Commission
211 No. Broadway
Wichita, Kansas

WELL PLUGGING RECORD

NORTH

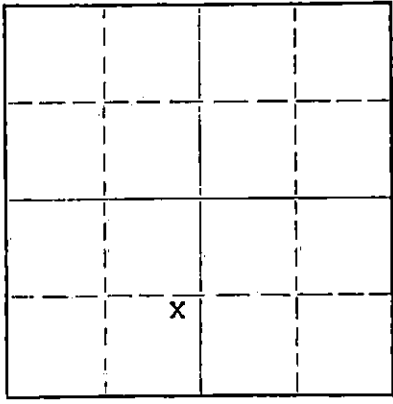

Locate well correctly on above Section Plat

Stafford County. Sec. 1 Twp. 25 Rge. 14 (E) (W)
Location as "NE/CNW%SW%" or footage from lines. NE SE SW
Lease Owner Aylward Drilling Company
Lease Name Bowker Well No. B-1
Office Address 813 First National Bank Bldg., Wichita 2
Character of Well (completed as Oil, Gas or Dry Hole)
Date well completed July 21 1960
Application for plugging filed 19
Application for plugging approved 19
Plugging commenced March 15 1963
Plugging completed March 18, 1963
Reason for abandonment of well or producing formation

If a producing well is abandoned, date of last production 19
Was permission obtained from the Conservation Division or its agents before plugging was commenced? yes

Name of Conservation Agent who supervised plugging of this well Archie V. Elving
Producing formation Depth to top Bottom Total Depth of Well 4213 Feet
Show depth and thickness of all water, oil and gas formations.

OIL, GAS OR WATER RECORDS

CASING RECORD

FORMATION	CONTENT	FROM	TO	SIZE	PUT IN	PULLED OUT
				8 5/8	226'	none
				4157	4 1/2"	2100'

Describe in detail the manner in which the well was plugged, indicating where the mud fluid was placed and the method or methods used in introducing it into the hole. If cement or other plugs were used, state the character of same and depth placed, from feet to feet for each plug set.

Filled hole with chat from 4157 feet to 4039 feet and dumped 3 sacks cement.
Set 15 foot rock bridge at 200 feet, dumped 5 sacks cement with dump bailer. Bailed fluid down and dumped 20 sacks
Mud hole to 40 feet, set 5 foot rock bridge and dumped 10 sacks.

RECEIVED
STATE CORPORATION COMMISSION

APR 1 1963

CONSERVATION DIVISION
Wichita, Kansas

(If additional description is necessary, use BACK of this sheet)
Name of Plugging Contractor Kent Well Servicing Company
Address Box 470, El Dorado, Kansas

STATE OF Kansas, COUNTY OF Butler, ss.

(employee of owner) or (owner or operator) of the above-described well, being first duly sworn on oath, says: That I have knowledge of the facts, statements, and matters herein contained and the log of the above-described well as filed and that the same are true and correct. So help me God.

(Signature) Mary Payne

SUBSCRIBED AND SWORN TO before me this 28th day of March, 1963

My commission expires June 18, 1963

Esther C. Phillips
Notary Public.