


STATE OF KANSAS
STATE CORPORATION COMMISSION
Give All Information Completely
Make Required Affidavit
Mail or Deliver Report to:
Conservation Division
State Corporation Commission
211 No. Broadway
Wichita, Kansas

WELL PLUGGING RECORD

NORTH

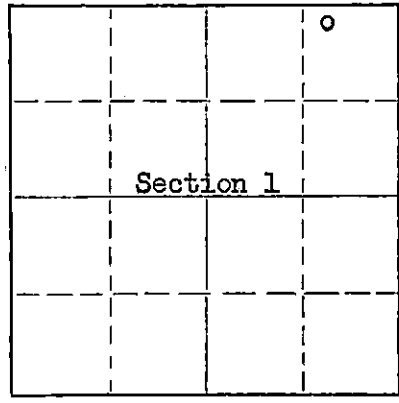

Locate well correctly on above Section Plat

Stafford County. Sec. 1 Twp. 25s Rge. 11 (E) W (W)
Location as "NE/CNW*SW*" or footage from lines NW NE NE
Lease Owner Petroleum, Inc.
Lease Name Goodman "B" Well No. 6
Office Address Route #2, Great Bend, Kansas
Character of Well (completed as Oil, Gas or Dry Hole) Dry Hole
Date well completed Oct 9 1960
Application for plugging filed Oct 9 1960
Application for plugging approved Oct 9 1960
Plugging commenced Oct 9 1960
Plugging completed Oct 9 1960
Reason for abandonment of well or producing formation No Producing Zones

If a producing well is abandoned, date of last production None 1960
Was permission obtained from the Conservation Division or its agents before plugging was commenced? Yes

Name of Conservation Agent who supervised plugging of this well Frank Broadfoot, St. John, Kansas
Producing formation -O* Depth to top --- Bottom --- Total Depth of Well 4228' Feet
Show depth and thickness of all water, oil and gas formations.

OIL, GAS OR WATER RECORDS

CASING RECORD

FORMATION	CONTENT	FROM	TD	SIZE	PUT IN	PULLED OUT
				8 5/8"	256'	None

Describe in detail the manner in which the well was plugged, indicating where the mud fluid was placed and the method or methods used in introducing it into the hole. If cement or other plugs were used, state the character of same and depth placed, from _____ feet to _____ feet for each plug set.

Mud up with heavy mud to 240' followed by a wooden plug. Placed 20 sacks of cement through drill pipe on top of plug. Mud up to 35' followed by a wooden plug. Filled hole to base of well cellar with 10 sacks of cement.

RECEIVED
STATE CORPORATION COMMISSION
NOV 14 1960
CONSERVATION DIVISION
Wichita, Kansas

(If additional description is necessary, use BACK of this sheet)
Name of Plugging Contractor Garvey Drilling Company
Address Route #2, Great Bend, Kansas

STATE OF Kansas, COUNTY OF Barton, ss.

(employee of owner) or (~~owner or operator~~) of the above-described well, being first duly sworn on oath, says: That I have knowledge of the facts, statements, and matters herein contained and the log of the above-described well as filed and that the same are true and correct. So help me God.

(Signature) Don Searle
Route #2, Great Bend, Kansas
(Address)

SUBSCRIBED AND SWORN TO before me this 11 day of November, 1960

My commission expires April 14, 1963
Arthur J. Mule
Notary Public.



R
WELL LOG

COMPANY PETROLEUM, INCORPORATED

SEC. 1 T-25S R- 14W

FARM GOODMAN "B" NO. 6


LOC. NW, NE, NE

TOTAL DEPTH 4228'

COUNTY STAFFORD CO., KASAS

COMM. September 29, 1960 COMP. October 9, 1960

CONTRACTOR GARVEY DRILLING COMPANY

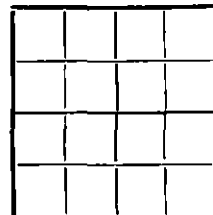

CASING 8 5/8" @ 256' w/225 sax.

ELEVATION 1949' DF

PRODUCTION D & A

FIGURES INDICATE BOTTOM OF FORMATIONS

140	Surface soil & sand
858	Shale & shells
880	Anhydrite
980	Shale & shells
1515	Shale
1795	Lime
2000 0	Lime & shale
2190	Lime
2560	Lime & shale
2710	Lime
3095	Lime & shale
3410	Lime
3495	Lime & shale
3555	Lime
3665	Lime & shale
4076	Lime
4110	Lime & chert
4145	Shale & chert
4205	Shale
4228	Lime & chert
4228	T. D.

RECEIVED
STATE CORPORATION COMMISSION

NOV 14 1960

CONSERVATION DIVISION
Wichita, Kansas

State of KANSAS }
County of BARTON } ss.

I, VERNE A. MORRIS of GARVEY DRILLING COMPANY

upon oath state that the above and foregoing is a true and correct copy of the log of the #6 GOODMAN "B" well

Verne A. Morris

Subscribed and sworn to before me this 9th day of November 19 60

My Commission Expires: April 14, 1963

Arthur J. Wiles

NOTARY PUBLIC