


STATE OF KANSAS
STATE CORPORATION COMMISSION

WELL PLUGGING RECORD

Give All Information Completely
Make Required Affidavit
Mail or Deliver Report to
Conservation Division
State Corporation Comm.
245 North Water
Wichita, KS 67202

Stafford County. Sec. 1 Twp. 25S Rge. 11W E/W
Location as "NE/CNW $\frac{1}{4}$ SW $\frac{1}{4}$ " or footage from lines
C INWSE NW

Lease Owner Ladd Petroleum Corporation
Lease Name Sanders #7 Well No. 7
Office Address 830 Denver Club Building, Denver, Colo. 80202
Character of Well (Completed as Oil, Gas or Dry Hole)

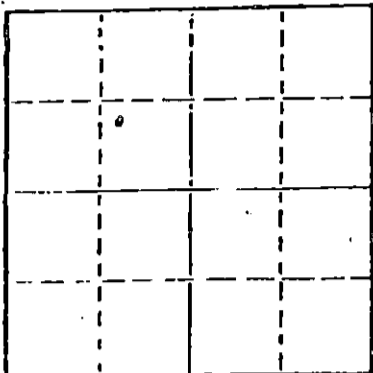

Locate well correctly on above
Section Plot

Dry Hole
Date Well completed August 16, 1979 19
Application for plugging filed August 16, 1979 19
Application for plugging approved August 16, 1979 19
Plugging commenced 5:00 PM, August 16, 1979 19
Plugging completed 6:30 PM, August 16, 1979 19
Reason for abandonment of well or producing formation

Dry Hole
If a producing well is abandoned, date of last production 19

Was permission obtained from the Conservation Division or its agents before plugging was commenced? Yes

Name of Conservation Agent who supervised plugging of this well W. T. Owen
Producing formation Depth to top Bottom Total Depth of Well 4310'
Show depth and thickness of all water, oil and gas formations.

OIL, GAS OR WATER RECORDS

CASING RECORD

FORMATION	CONTENT	FROM	TO	SIZE	PUT IN	PULLED OUT
				8 5/8"	338'	None

Describe in detail the manner in which the well was plugged, indicating where the mud fluid was placed and the method or methods used in introducing it into the hold. If cement or other plugs were used, state the character of same and depth placed, from _____ feet to _____ feet for each plug set.

Filled hole with heavy mud.
Plugged with 40 sacks 60/60 Pozmix with 2% gel
at 540'; 35 sacks at 300'; 10 sacks 0 to 30'.
3 sacks in rathole and 2 sacks in mousehole.

STATE RECEIVED
CORPORATION COMMISSION
AUG 22 1979
CONSERVATION DIVISION
Kansas

(If additional description is necessary, use BACK of this sheet)

Name of Plugging Contractor Sterling Drilling Company, P. O. Box 129, Sterling, Kansas 67579

STATE OF KANSAS COUNTY OF RICE, ss.
F. A. Wuellner (employee of owner) or (owner or operator)
of the above-described well, being first duly sworn on oath, says: That I have knowledge of the facts, statements, and matters herein contained and the log of the above-described well as filed and that the same are true and correct. So help me God.

(Signature) F. A. Wuellner
STERLING DRILLING COMPANY
F. A. Wuellner, Secretary
P. O. Box 129, Sterling, Kansas 67579
(Address)

SUBSCRIBED AND SWORN TO before me this 17th day of August, 1979

My commission expires _____



Charles M. Hall
Charles M. Hall, Notary Public.

STERLING DRILLING COMPANY
P. O. Box 129
Sterling, Kansas 67579

WELL LOG - - - - - SANDERS #7
Located: C NW SE NW, Section 1-25S-11W, Stafford County,
Kansas

OWNER: Ladd Petroleum Corporation
ROTARY DRILLING CONTRACTOR: Sterling Drilling Company

COMMENCED: August 5, 1979
COMPLETED: August 16, 1979

TOTAL DEPTH: 4310'

LOG

CASING RECORD

0 - 300	Sand and Shale	Ran 11 joints 8 5/8" casing, 325' set at 338' K.B. Cemented with 275 sacks Class A with 2% gel and 3% co. Plug down at 7:15 PM, 8-5-79.
300 - 1945	Shale	
1945 - 2908	Lime and Shale	
2908 - 3090	Lime and Shale Stks.	
3090 - 3878	Lime and Shale	
3878 - 4025	Lime	
4025 - 4232	Lime and Shale	
4232 - 4270	Lime	
4270 - 4310	Lime and Shale	Plugged.

Deviation Surveys: 3/4° at 1900'
1 1/4° at 3826'

RECEIVED
STATE CORPORATION COMMISSION

AUG 22 1979