


STATE OF KANSAS
STATE CORPORATION COMMISSION

WELL PLUGGING RECORD

Give All Information Completely
Make Required Affidavit
Mail or Deliver Report to
Conservation Division
State Corporation Comm.
245 North Water
Wichita, KS 67202

Stafford County, Sec. 2 Twp. 25S Rge. 14W E/W
Location as "NE/CNW $\frac{1}{4}$ SW $\frac{1}{4}$ " or footage from lines
NE NE NW

Lease Owner American Energies Corp.
Lease Name CHAPPELL Well No. 1
Office Address 575 Fourth Financial Ctr., Wichita, Kansas
Character of Well (Completed as Oil, Gas or Dry Hole)
Dry Hole

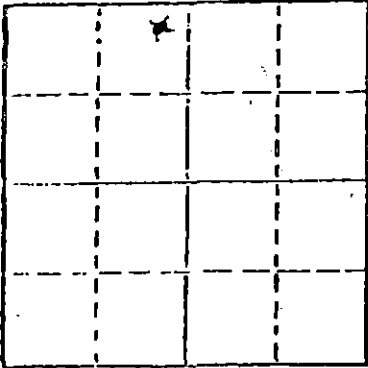

Locate well correctly on above
Section Plot

Date Well completed 10/27/1980
Application for plugging filed (Verbally) 10/27/1980
Application for plugging approved (Verbally) 10/27/1980
Plugging commenced 10/27/1980
Plugging completed 10/27/1980
Reason for abandonment of well or producing formation
No commercial quantity of oil or gas encountered
If a producing well is abandoned, date of last production 19

Was permission obtained from the Conservation Division or
its agents before plugging was commenced? Yes

Name of Conservation Agent who supervised plugging of this well Dwayne Rankin
Producing formation _____ Depth to top _____ Bottom _____ Total Depth of Well _____
Show depth and thickness of all water, oil and gas formations.

OIL, GAS OR WATER RECORDS

CASING RECORD

FORMATION	CONTENT	FROM	TO	SIZE	PUT IN	PULLED OUT

Describe in detail the manner in which the well was plugged, indicating where the mud fluid
was placed and the method or methods used in introducing it into the hold. If cement or other
plugs were used, state the character of same and depth placed, from _____ feet to
_____ feet for each plug set.

T.D. 4310', Filled hole with mud, pumped 40 sx. of
50/50 posmix, 4% gel thru open end of drill pipe
@ 420', mud to 330', pumped 30 sx., mud to 40',
1/2 sx. hulls and wood plug for solid bridge.
Pumped 10 sx. to base of cellar, 10 sx. in rathole,
5 sx. in water well. Job complete @ 11:30 p.m. 10-27-80.
Cement by Sun. State Pluggger - Dwayne Rankin,
Great Bend, Kansas.

RECEIVED
STATE CORPORATION COMMISSION

NOV - 3 1980

(If additional description is necessary, use BACK of this sheet)

Name of Plugging Contractor KAW Drilling Co., Inc.

CONSERVATION DIVISION
Wichita, Kansas

STATE OF Kansas COUNTY OF Sedgwick, ss.
K.S. Martin, President (employee of owner) or (owner or operator)
of the above-described well, being first duly sworn on oath, says: That I have knowledge of
the facts, statements, and matters herein contained and the log of the above-described well
as filed and that the same are true and correct. So help me God.

(Signature) K.S. Martin
1010 Union Center, Wichita, Kansas 67202
(Address)

SUBSCRIBED AND SWORN TO before me this 29th day of October, 1980



Kathy S. Goertz
Kathy S. Goertz Notary Public.

My commission expires

CONTRACTOR'S WELL LOG

OPERATOR: American Energies Corp.
 CONTRACTOR: KAW Drilling Co., Inc.
 WELL NAME: Chappell #1
 LOCATION: NE NE NW, Section 2-25S-14W.
 Stafford County, Kansas.
 SPUD DATE: October 20, 1980
 COMPLETION DATE: October 27, 1980

0	260	Shale, sand, shells, clay
260	345	Shale, sand, clay
345	610	Shale, shells, sand
610	852	Shale, red beds
852	874	Anhydrite
874	1875	Shale
1875	2420	Shale & lime
2420	2740	Shale
2740	4040	Lime & shale
4040	4118	Lime
4118	4252	Lime & shale
4252	4310	Lime
	4310	R.T.D.

SAMPLE TOPS:

Anhydrite 852' (+1110)
 B/Anhydrite 874' (+1088)

Spud hole @ 1:20 p.m. 10-20-80. Drilled 345' of 12 1/2" hole. Ran 7 jts. of 8 5/8" - 28#, used casing & 1 jt. of 8 5/8" - 20# new casing. (Tallied 329') Set @ 340' K.B. with 260 sx. of 60/40 posmix, 2% gel, 3% Ca.Cl. Plug was down @ 6:00 p.m. 10-20-80.

T.D. 4310', Filled hole with mud, pumped 40 sx. of 50/50 posmix, 4% gel thru open end of drill pipe @ 420', mud to 330', pumped 30 sx., mud to 40', 1/2 sx. hulls and wood plug for solid bridge. Pumped 10 sx. to base of cellar, 10 sx. in rathole, 5 sx. in water well. Job complete @ 11:30 p.m. 10-27-80. Cement by Sun. State Plugger - Dwayne Rankin, Great Bend, Kansas.

RECEIVED

STATE OF KANSAS)
) SS
 COUNTY OF SEDGWICK)


STATE CORPORATION COMMISSION

NOV - 3 1980

K.S. Martin, President of KAW Drilling Co., Inc., being first duly sworn on oath, says: That I have knowledge of the facts, statements and matters herein contained and the log of the above described well as filed and that the same are true and correct. So help me God.

K.S. Martin
 K.S. Martin, President

SUBSCRIBED AND SWORN TO before me this 29th day of October, 1980.

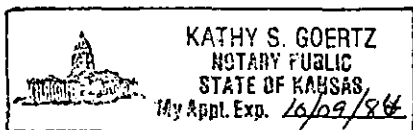

Kathy S. Goertz
 Kathy S. Goertz, Notary Public