


STATE OF KANSAS
STATE CORPORATION COMMISSION

Give All Information Completely
Make Required Affidavit
Mail or Deliver Report to:
Conservation Division
State Corporation Commission
211 No. Broadway
Wichita, Kansas

WELL PLUGGING RECORD

NORTH

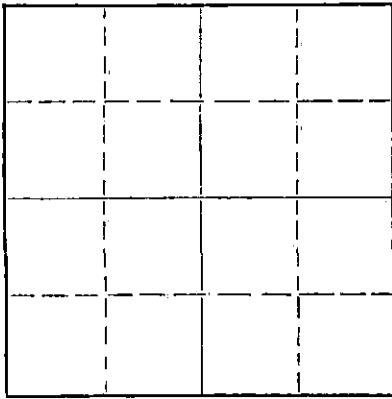

Locate well correctly on above
Section Plat

Stafford County, Sec. 2 Twp. 25 Rge. 14 (W)
Location as "NE/CNW/SW" or footage from lines E/2 SE NE
Lease Owner Aylward Drilling Company
Lease Name Bowker "A" Well No. 1
Office Address 813 1st Natl. Bank Bldg. - Wichita, Kansas
Character of Well (completed as Oil, Gas or Dry Hole) Dry Hole
Date well completed July 3 1959
Application for plugging filed July 3 1959
Application for plugging approved July 3 1959
Plugging commenced July 3 1959
Plugging completed July 3 1959
Reason for abandonment of well or producing formation

If a producing well is abandoned, date of last production 19
Was permission obtained from the Conservation Division or its agents before plugging was commenced? Yes

Name of Conservation Agent who supervised plugging of this well Frank Broadfoot - St. John, Kansas
Producing formation Depth to top Bottom Total Depth of Well 430.8' Feet
Show depth and thickness of all water, oil and gas formations.

OIL, GAS OR WATER RECORDS

CASING RECORD

FORMATION	CONTENT	FROM	TO	SIZE	PUT IN	PULLED OUT
				8 5/8"	242'	None

Describe in detail the manner in which the well was plugged, indicating where the mud fluid was placed and the method or methods used in introducing it into the hole. If cement or other plugs were used, state the character of same and depth placed, from feet to feet for each plug set.

Filled hole with heavy mud from total depth to 225';
set Halliburton plug with 20 sacks cement and 1/3 sack hulls to 175';
heavy mud from 175' to 35'; Halliburton plug with 10 sacks of cement
and 1/3 sack hulls to to surface.

RECEIVED
STATE CORPORATION COMMISSION

OCT 21 1959

Conservation Division
Wichita, Kansas

(If additional description is necessary, use BACK of this sheet)

Name of Plugging Contractor Aylward Drilling Company
Address 813 1st Natl. Bank Bldg. - Wichita, Kansas

STATE OF Kansas, COUNTY OF Sedgwick, ss.
Paul W. Hesse (employee of owner) or (owner or operator) of the above-described well, being first duly sworn on oath, says: That I have knowledge of the facts, statements, and matters herein contained and the log of the above-described well as filed and that the same are true and correct. So help me God.

(Signature)

813 1st Natl. Bank Bldg. - Wichita, Kansas
(Address)

SUBSCRIBED AND SWORN TO before me this 16th day of July, 1959

My commission expires December 11, 1961

Notary Public.

BOWKER NO. 1 "A"

Casing Record:

8 5/8" - 240'

Company: Aylward Drilling Company et al
Contractor: Aylward Drilling Company

Commenced: June 20, 1959

Completed: July 3, 1959

Location: C E 1/2 SE NE
Section 2-25-14W
Stafford County
Kansas

Elevation: 1958 R.B.

	<u>From</u>	<u>To</u>	<u>Remarks</u>
Sand	0	140	Set 8 5/8" @ 240' w/200 sax cement
Shale	140	240	
Red Bed	240	450	Geological Tops:
Sand & Red Bed	450	600	
Red Bed	600	890	Heebner 3517
Anhydrite	890	910	Toronto 3540
Shale & Shells	910	1356	Douglas 3560
Shale - Lime Streaks	1356	1580	Brown Lime 3660
Shale & Shells w/Lime Streaks	1580	1720	Lansing 3686
Lime & Shale	1720	1820	Mississippian 4062
Lime	1820	1945	Kinderhook 4102
Lime w/Shale	1945	2068	Viola 4164
Lime & Shale	2068	2200	Simpson 4252
Shale w/Lime Streaks	2200	2285	Arbuckle 4300
Lime & Shale	2285	2396	
Shale & Lime	2396	2825	DST 4022-4103 Open 1 hr.
Shale w/Lime	2825	2965	Rec. 2468' GCMSW
Shale & Lime	2965	3165	IBHP 1320#/20" - FBHP 1270#/30"
Lime	3165	3205	FP 670#-1230#
Chalky Lime & Shale	3205	3285	
Lime	3285	3510	
Lime & Shale	3510	3635	
Lime	3635	3994	
Lime & Shale	3994	4060	
Lime	4060	4103	
Lime & Shale	4103	4108	
Shale	4108	4167	
Chert & Shale	4167	4175	
Cherty Shale	4175	4214	
Lime - Cherty	4214	4232	
Shale & Lime	4232	4307	
Lime	4307	4318 T.D.	D & A

I hereby certify that this is a true and correct copy of the above log to the best of my knowledge.

Paul W. Hesse

Subscribed and sworn to before me this 16th day of July, 1959
Duane Jessup

Notary Public

My commission expires December 11, 1961

RECEIVED
STATE CORPORATION COMMISSION

OCT 21 1959

CONSERVATION DIVISION
Wichita, Kansas