


STATE OF KANSAS
STATE CORPORATION COMMISSION

Form CP-4

Give All Information Completely
Make Required Affidavit
Mail or Deliver Report to:
Conservation Division
State Corporation Commission
212 No. Market
Wichita, Kansas

WELL PLUGGING RECORD

T - 25S NORTH R - 14W

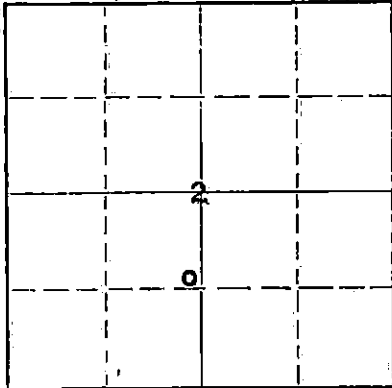

Locate well correctly on above
Section Plat

Stafford County. Sec. 2 Twp. 25 Rge. 14W (E) (W)
Location as "NE/CNW/SW" or footage from lines SE NE SW
Lease Owner Frank Black
Lease Name Hattie B Well No. 3
Office Address McPherson, Kansas
Character of Well (completed as Oil, Gas or Dry Hole) Oil
Date well completed 3-11-54 19
Application for plugging filed 5-15-67 19
Application for plugging approved 5-16-67 19
Plugging commenced 6/3/67 19
Plugging completed 6/6/67 19
Reason for abandonment of well or producing formation depleted.

If a producing well is abandoned, date of last production 19
Was permission obtained from the Conservation Division or its agents before plugging was commenced? yes

Name of Conservation Agent who supervised plugging of this well Elving
Producing formation Depth to top Bottom Total Depth of Well 4280 Feet
Show depth and thickness of all water, oil and gas formations.

OIL, GAS OR WATER RECORDS

CASING RECORD

FORMATION	CONTENT	FROM	TO	SIZE	PUT IN	PULLED OUT
				8-5/8"	874'	none
				5-1/2"	4305'	2809'

Describe in detail the manner in which the well was plugged, indicating where the mud fluid was placed and the method or methods used in introducing it into the hole. If cement or other plugs were used, state the character of same and depth placed, from feet to feet for each plug set.

Checked hole, sanded hole to 3900' and set 5 sacks of cement.
Loaded hole with water, shot pipe at 3001', 2909', 2818',
mudded hole to 400'. Set rock bridge and ran 25 sacks of cement.
Mudded hole to 40', set 10' rock bridge and ran 10 sacks of
cement. Tallied pipe.

RECEIVED
STATE CORPORATION COMMISSION

JUN 13 1967

PLUGGING COMPLETE.

CONSERVATION DIVISION
Wichita, Kansas

(If additional description is necessary, use BACK of this sheet)

Name of Plugging Contractor KNIGHT CASING PULLING COMPANY License #436
Address CHASE, KANSAS

STATE OF KANSAS COUNTY OF RICE, ss.
NOEL J. KNIGHT (employee of owner) or (owner or operator) of the above-described

well, being first duly sworn on oath, says: That I have knowledge of the facts, statements, and matters herein contained and the log of the above-described well as filed and that the same are true and correct. So help me God.

(Signature) Noel Knight
CHASE, KANSAS
(Address)

SUBSCRIBED AND SWORN TO before me this 9th day of June, 19 67

Margaret Melcher
Notary Public.

My commission expires February 15, 1971.

WELL LOG BUREAU - KANSAS GEOLOGICAL SOCIETY
508 East Murdock,
Wichita, Kansas

COPY


Company- PHILLIPS PETROLEUM CO.
Farm- Hattie "B" No. 3

SEC. 2
S.E.

T. 25 R. 14W
SE NE SW

Total Depth. 4280 PB 4114 1/2
Comm. 1-30-54 Comp. 3-11-54
Shot or Treated.
Contractor.
Issued. 4-2-55

County Stafford
KANSAS

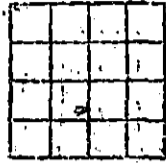

Elevation. 1961 D.F.

Production. BHB 1793 BO & no water

Figures indicate Bottom of Formations.

sand, shells, redbed 910
shale, salt, shells 1578
shale, shells 1932
lime 2243
shale, shells 2354
shale 2535
shale, lime 2803
shale 3012
shale, lime streaks 3202
lime 3513
lime, shale 3635
shale 3678
lime 3713
lime, chert 3831
lime 3917
lime, chert 4040
lime 4080
lime, shale, chert 4150
lime, chert 4267
lime 4280
Total Depth PN 4114 1/2

Tops:
Heebner 3504
Toronto 3523
Brown Lime 3641
Lansing-K. C. 3672
Base L.K.C. 3952
Marmaton 3963
Miss. chert 4017
Kinderhook 4050
Viola 4113
Crystalline Viola 4251
Simpson 4274

RTD 4280, PB 4242, Perf.
5 1/2" 4155-67 w/48 shots.
test 2 GW. Acid 500 gals,
Bailed 2 1/2 BO & 5 BW 7 1/4 hrs.
Dumped in cement to PBD 4114 1/2,
perf. 5 1/2" 4131-45
w/56 jet shots, swb & bailed
dry, then bailed 29 1/2 GO & 2 BW
in 3 hrs. Acid w/500 gal & 2500
gals. test 259 BO & 2 1/2 BW in
8 1/2 hrs.

RECEIVED
STATE CORPORATION COMMISSION
MAY 16 1967
CONSERVATION DIVISION
Wichita, Kansas