


STATE OF KANSAS
STATE CORPORATION COMMISSION

Give All Information Completely
Make Required Affidavit
Mail or Deliver Report to:
Conservation Division
State Corporation Commission
211 No. Broadway
Wichita, Kansas

WELL PLUGGING RECORD

NORTH

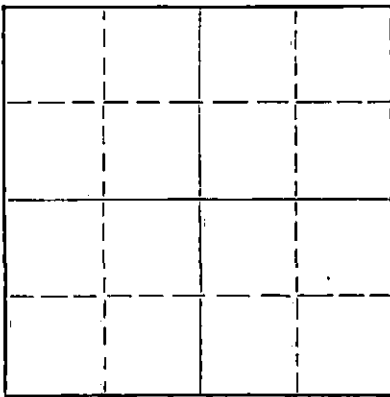

Locate well correctly on above
Section Plat

Stafford County. Sec. 2 Twp. 25S Rge. (E) 14 (W)
Location as "NE/CNW/SW" or footage from lines SW SE SW
Lease Owner Phillips Petroleum Company
Lease Name Hattie "B" Well No. 1
Office Address Box 287 - Great Bend, Kansas.
Character of Well (completed as Oil, Gas or Dry Hole) Oil
Date well completed October 10, 19 53
Application for plugging filed May 2, 19 61
Application for plugging approved May 3, 19 61
Plugging commenced May 11, 19 61
Plugging completed May 17, 19 61
Reason for abandonment of well or producing formation Uneconomical to operate

If a producing well is abandoned, date of last production March 16, 19 61
Was permission obtained from the Conservation Division or its agents before plugging was commenced? Yes

Name of Conservation Agent who supervised plugging of this well Mr. Frank Broadfoot
Producing formation Viola Depth to top 4102 Bottom Total Depth of Well 4179 PB Feet
Show depth and thickness of all water, oil and gas formations.

OIL, GAS OR WATER RECORDS

CASING RECORD

FORMATION	CONTENT	FROM	TO	SIZE	PUT IN	PULLED OUT
Heebner	Dry	3502		10 3/4"	860.56	None
Toronto	Dry	3521				
Douglas	Dry	3540		7"	4245.65	2132.00'
Brown Lime	Dry	3642				
LKC	Dry	3673	3952			
Marmaton	Dry	3963				
Mississippi	Dry	4025				
Viola	Oil	4102				

Describe in detail the manner in which the well was plugged, indicating where the mud fluid was placed and the method or methods used in introducing it into the hole. If cement or other plugs were used, state the character of same and depth placed, from feet to feet for each plug set.

Dumped sand from 4179' to 4020'. Dumped 5 sx. cement to 3975'.
Mudded hole from 3975' to 250'. Set rock bridge to 240', dumped 35 sx.
cement to 170', mudded hole to 35' and set rock bridge to 30', dumped
15 sx. cement in filling to base of cellar.

RECEIVED
STATE CORPORATION COMMISSION
MAY 19 1961
CONSERVATION DIVISION
Wichita, Kansas

(If additional description is necessary, use BACK of this sheet)

Name of Plugging Contractor Knight Casing Pulling Company
Address Great Bend, Kansas.

STATE OF KANSAS, COUNTY OF BARTON, ss.
M. E. Michael (employee of owner) or (owner or operator) of the above-described well, being first duly sworn on oath, says: That I have knowledge of the facts, statements, and matters herein contained and the log of the above-described well as filed and that the same are true and correct. So help me God.

(Signature) M. E. Michael
Box 287 - Gt. Bend, Kansas.
(Address)

SUBSCRIBED AND SWORN TO before me this 18th day of May, 19 61

My commission expires 11/18/61

Notary Public.



EXPLORATION RECORD

Lease Hattie "B"

Well 1

Formation Name	Top	Base	Remarks
Surface Shale and Sand	0	473	
Shale and Shells	473	863	
Shale and Shells Anhydrite	863	1432	
Shale and Shells	1432	1787	
Lime	1787	1945	
Lime and Shale	1945	2356	
Lime, Shale and Salt	2356	2483	
Lime	2483	2500	
Lime and Shale	2500	2628	
Shale	2628	2688	
Shale and Lime	2688	2770	
Shale	2770	3004	
Lime and Shale	3004	3340	
Lime	3340	3417	
Lime and Shale	3417	3475	
Lime	3475	3520	
Lime and Shale	3520	3753	
Lime	3753	3974	
Lime and Shale	3974	4056	
Lime	4056	4116	
Lime and Shale	4116	4172	
Lime	4172	4194	
Lime and Shale	4194	4247	
Shale	4247	4268	
Lime and Chert			
Chert			
Lime and Chert			
Lime			

RECEIVED
STATE CORPORATION COMMISSION

MAY 19 1961

CONSERVATION DIVISION
Wichita, Kansas