


STATE OF KANSAS
STATE CORPORATION COMMISSION

WELL PLUGGING RECORD

Give All Information Completely
Make Required Affidavit
Mail & Deliver Report to:
Conservation Division
State Corporation Commission
211 No. Broadway
Wichita, Kansas

NORTH

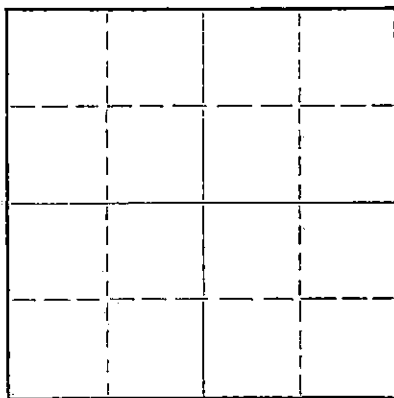

Locate well correctly on above
Section Plat

Stafford County, Sec. 2 Twp. 25 Rge. (E) 14 (W)
Location as "NE/CNW/SW" or footage from lines C NW NE NE
Lease Owner Musgrove Petroleum Corporation
Lease Name BOWKER Well No. 1
Office Address 801 Union Center, Wichita, Kansas
Character of Well (completed as Oil, Gas or Dry Hole) Dry Hole
Date well completed March 19, 19 58
Application for plugging filed verbally March 18, 19 58
Application for plugging approved verbally March 18, 19 58
Plugging commenced March 19, 19 58
Plugging completed March 19, 19 58
Reason for abandonment of well or producing formation Dry

If a producing well is abandoned, date of last production 19
Was permission obtained from the Conservation Division or its agents before plugging was commenced? Verbally - yes

Name of Conservation Agent who supervised plugging of this well Eldon Petty
Producing formation Depth to top Bottom Total Depth of Well 4345 Feet
Show depth and thickness of all water, oil and gas formations.

OIL, GAS OR WATER RECORDS

CASING RECORD

FORMATION	CONTENT	FROM	TO	SIZE	PUT IN	PULLED OUT
				8-5/8"	334'	

Describe in detail the manner in which the well was plugged, indicating where the mud fluid was placed and the method or methods used in introducing it into the hole. If cement or other plugs were used, state the character of same and depth placed, from feet to feet for each plug set.

Filled hole with heavy mud to 300' .
Set 1st plug at 300' w/1/2 sk hulls & 20 sx cement.
Filled hole with heavy mud to 40'.
Set 2nd plug at 40' w/10 sx cement.

RECEIVED
ST. REC. DIV. 17
3-22-58
MAR 22 1958
CON. DIV.

(If additional description is necessary, use BACK of this sheet)
Name of Plugging Contractor Musgrove Petroleum Corporation
Address 801 Union Center, Wichita, Kansas

STATE OF Kansas, COUNTY OF Sedgwick
I, Emil E. Bowers, (employee of owner) or (owner or operator) of the above-described well, being first duly sworn on oath, says: That I have knowledge of the facts, statements, and matters herein contained and the log of the above-described well as filed and that the same are true and correct. So help me God.


(Signature) Emil E. Bowers
801 Union Center, Wichita, Kansas
(Address)

SUBSCRIBED AND SWORN to before me this 21st day of March, 19 58

Leah Joyce Neff

Notary Public.

My commission expires June 16, 1959.

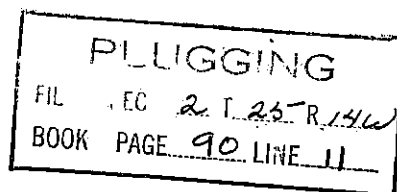

CONTRACTOR'S WELL LOG

COMPANY: Musgrove Petroleum Corporation
CONTRACTOR: Musgrove Petroleum Corporation
FARM: BOWKER #1
LOCATION: C NW NE NE, Sec. 2-25-14W
Stafford County, Kansas
COMMENCED: March 6, 1958
COMPLETED: March 19, 1958

0	260	Sand & shale
260	335	Shale & shells
335	775	Sand, shale & red bed
775	1353	Shale & red bed
1353	1745	Shale & shells
1745	3490	Lime & shale
3490	3585	Lime
3585	3800	Lime & shale
3800	3833	Lime
3833	4140	Lime & shale
4140	4150	Lime
4150	4210	Lime & shale
4210	4240	Lime
4240	4325	Lime & shale
4325	4345	Lime
	4345	Rotary Total Depth

Set 8-5/8" surface casing at 334' with 275 sacks Posmix.

DRY & ABANDONED

ELEVATION:	1959' D.F.	TOPS:	Sample	Schlumberger
	1961' K.B.	Heebner	3506'	3500' (-1539)
		Lansing	3677'	3666' (-1705)
		Base K.C.	3950'	3944' (-1983)
		Miss.	4013'	4004' (-2043)
		Viola	4112'	4110' (-2149)
		Simpson	4260'	4254' (-2293)
		Arbuckle	4316'	4312' (-2351)

STATE OF KANSAS)
COUNTY OF SEDGWICK) SS

MAR 22 1958
CONSERVATION DIVISION
Wichita, Kansas

I, EMIL E. BOWERS, do hereby certify that the above and foregoing is a true and correct copy of the log of the BOWKER #1, C NW NE NE, Section 2-25-14W, Stafford County, Kansas, as reflected by the files of the Musgrove Petroleum Corporation.

MUSGROVE PETROLEUM CORPORATION

BY Emil E. Bowers
Secretary-Treasurer

Subscribed and sworn to before me, a Notary Public, in and for Sedgwick County, Kansas, this 21st day of March, 1958.

Lois Jane Hickey
Notary Public

My commission expires June 16, 1959.

