

CARD MUST BE TYPED

State of Kansas **CORRECTION OF GRID/SITE LOCATION**
NOTICE OF INTENTION TO DRILL 5-2-85 CARD MUST BE SIGNED
(see rules on reverse side)

Starting Date: May 18, 1985
month day year

OPERATOR: License # 6289

Name William Guy Bumgarner

Address 509 N. Main

City/State/Zip Grenola, Kansas 67346

Contact Person Nick Klein

Phone 316/445-2252

CONTRACTOR: License # 5302

Name Red Tiger Drilling Company

City/State Wichita, KS. 67202

Well Drilled For: Well Class: Type Equipment:

- Oil Swd Infield Mud Rotary
- Gas Inj Pool Ext. Air Rotary
- OWWO Expl. Wildcat Cable

If OWWO: old well info as follows:

Operator

Well Name

Comp Date Old Total Depth

Projected Total Depth 4050 feet

Projected Formation at TD Viola

Expected Producing Formations Meisener/Viola

I certify that we will comply with K.S.A. 55-101, et seq., plus eventually plugging hole to K.C.C. specifications, 4/28/85

May 16, 1985

Date Signature of Operator or Agent

James J. Breitenbach
Title

4355 FSL
Operator's Agent

API Number 15-155-21, 053-0000

Swd Swd
Swd NW/4 Sec 14 Twp 26S S, Rge 5W East
(location) West

* 3035 Ft North from Southeast Corner of Section
4940 Ft West from Southeast Corner of Section
(Note: Locate well on Section Plat on reverse side)

Nearest lease or unit boundary line 340 feet.

County Rego

Lease Name Preisser Well# 1

Domestic well within 330 feet : yes no

Municipal well within one mile : yes no

Depth to Bottom of fresh water 30 feet

Lowest usable water formation Ninnescah Shale

Depth to Bottom of usable water 100 feet

Surface pipe by Alternate : 1 2

Surface pipe to be set 160 feet

Conductor pipe if any required Not required feet

Ground surface elevation 1436 feet MSL

This Authorization Expires 11-16-85


Approved By 5-16-85

RECEIVED
STATE CORPORATION COMMISSION

Must be filed with the K.C.C. five (5) days prior to commencing well
This card void if drilling not started within six (6) months of date received by K.C.C.

MAY 30 1985
5-30-85

CONSERVATION DIVISION
A Regular Section of Land
1 Mile = 5,280 Ft.

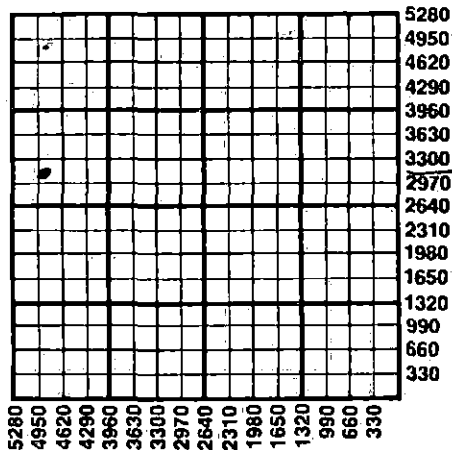

Important procedures to follow :

1. Notify District office before setting surface casing.
2. Set surface casing by circulating cement to the top.
3. File completion forms ACO-1 with K.C.C. within 90 days of well completion, following instructions on ACO-1, side 1, and including copies of wireline logs.
4. Notify District office 48 hours prior to old well workover or re-entry.
5. Prior to plugging, prepare a plugging plan, then obtain agreement from the appropriate district office for an approved plugging plan.
6. Submit plugging report (CP-4) to K.C.C. after plugging is completed.
7. Obtain an approved injection docket number before disposing of salt water.
8. Notify K.C.C. within 10 days when injection commences or terminates.
9. If an alternate 2 completion, cement in the production pipe from below any usable water to surface within 120 days of spud date.

State Corporation Commission of Kansas
Conservation Division
200 Colorado Derby Building
Wichita, Kansas 67202
(316) 263-3238