

STATE OF KANSAS  
STATE CORPORATION COMMISSION

WELL PLUGGING RECORD

Give All Information Completely  
Make Required Affidavit  
Mail or Deliver Report to  
Conservation Division  
State Corporation Comm.  
245 North Water  
Wichita, KS 67202

Stafford County, Sec. 9 Twp. 25S Rge. 11W xExx  
Location as "NE/CNW $\frac{1}{4}$ SW $\frac{1}{4}$ " or footage from lines  
C E/2 NE/4


Lease Owner P.V. Properties, Inc.  
Lease Name Baar Well No. 1  
Office Address 360 Sutton Place, Wichita 67202  
Character of Well (Completed as Oil, Gas or Dry Hole) Dry Hole

Date Well completed 12/30/80 19  
Application for plugging filed 12/30/80 19  
Application for plugging approved 12/30/80 19  
Plugging commenced 12/30/80 19  
Plugging completed 12/30/80 7 a.m. 19  
Reason for abandonment of well or producing formation \_\_\_\_\_

If a producing well is abandoned, date of last production \_\_\_\_\_ 19

Was permission obtained from the Conservation Division or its agents before plugging was commenced? Yes

Name of Conservation Agent who supervised plugging of this well Wm. T. Owen  
Producing formation \_\_\_\_\_ Depth to top \_\_\_\_\_ Bottom \_\_\_\_\_ Total Depth of Well \_\_\_\_\_  
Show depth and thickness of all water, oil and gas formations. RTD 3540'

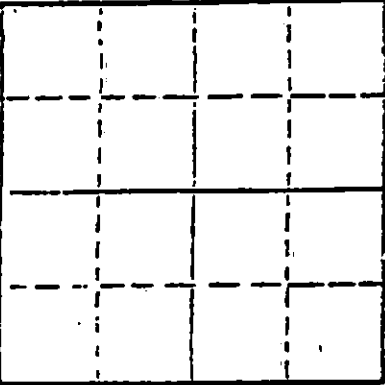

Locate well correctly on above Section Plot

OIL, GAS OR WATER RECORDS

CASING RECORD

FORMATION	CONTENT	FROM	TO	SIZE	PUT IN	PULLED OUT
	Surface	0	294	8-5/8"	yes	no

Describe in detail the manner in which the well was plugged, indicating where the mud plug was placed and the method or methods used in introducing it into the hold. If cement or other plugs were used, state the character of same and depth placed, from \_\_\_\_\_ feet to \_\_\_\_\_ feet for each plug set.

1st plug @ 500' with 50 sacks  
2nd plug @ 290' with 30 sacks  
3rd plug @ 40' with 10 sacks  
10 sacks in rathole

RECEIVED  
STATE CORPORATION COMMISSION

1-6-81 JAN 6 1981

(If additional description is necessary, use BACK of this sheet)  
Name of Plugging Contractor SLAWSON DRILLING COMPANY, INC. CONSERVATION DIVISION  
Wichita, Kansas

TATE OF Kansas COUNTY OF Sedgwick, ss.  
James C. Remsberg, Slawson Drilling Co., Inc. (employee of owner) or (owner or operator)  
of the above-described well, being first duly sworn on oath, says: That I have knowledge of the facts, statements, and matters herein contained and the log of the above-described well is filed and that the same are true and correct. So help me God.

(Signature) James C. Remsberg  
James C. Remsberg  
200 Douglas Building, Wichita 67202  
(Address)

SUBSCRIBED AND SWORN TO before me this 5 day of January, 19 81

Mary Lou Taylor  
Mary Lou Taylor Notary Public.

My commission expires January 17, 1985

