

Give All Information Completely
Make Required Affidavit
Mail or Deliver Report to:
Conservation Division
State Corporation Commission
211 No. Broadway
Wichita, Kansas

WELL PLUGGING RECORD

Stafford County, Sec. 10 Twp. 25 Rge. (E) 11 (W)

Location as "NE/CNW%SW%" or footage from lines SW SW NW

Lease Owner Petroleum Repressuring, Inc.

Lease Name McCune Well No. 1

Office Address 710 Union National Building, Wichita, Kansas

Character of Well (completed as Oil, Gas or Dry Hole) dry hole

Date well completed April 29 19 65

Application for plugging filed May 3, 1965 19

Application for plugging approved 19


Plugging commenced 4:45 p.m., April 29, 19 65

Plugging completed 6:45 p.m., April 29, 19 65

Reason for abandonment of well or producing formation dry hole

If a producing well is abandoned, date of last production 19

Was permission obtained from the Conservation Division or its agents before plugging was commenced? yes

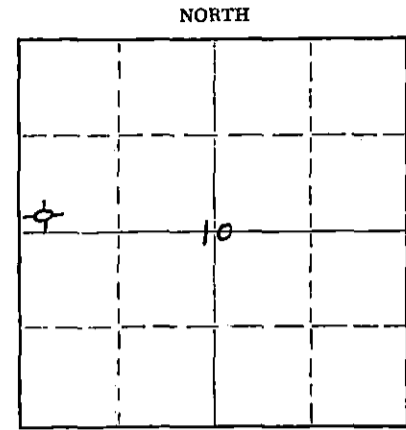

Locate well correctly on above Section Plat

Name of Conservation Agent who supervised plugging of this well Archie Elving

Producing formation _____ Depth to top _____ Bottom _____ Total Depth of Well _____ Feet

Show depth and thickness of all water, oil and gas formations.

OIL, GAS OR WATER RECORDS

CASING RECORD

FORMATION	CONTENT	FROM	TO	SIZE	PUT IN	PULLED OUT
		0'	229'	8 5/8"	229'	none

Describe in detail the manner in which the well was plugged, indicating where the mud fluid was placed and the method or methods used in introducing it into the hole. If cement or other plugs were used, state the character of same and depth placed, from _____ feet to _____ feet for each plug set.

Bottom plug @ 210' with 1/4 sack hulls and 25 sx cement.

Top plug @ 40' with 1/2 sack hulls & 10 sx cement.

s sx cement in rat hole.

5-4-65

RECEIVED
STATE CORPORATION COMMISSION
MAY 4 1965

CONSERVATION DIVISION
Wichita, Kansas

(If additional description is necessary, use BACK of this sheet)

Name of Plugging Contractor Vaughan Drilling, Inc.

Address Box 825, Great Bend, Kansas

STATE OF KANSAS, COUNTY OF BARTON, ss.

Donald D. Vaughan (employee of owner) or (owner or operator) of the above-described well, being first duly sworn on oath, says: That I have knowledge of the facts, statements, and matters herein contained and the log of the above-described well as filed and that the same are true and correct. So help me God.

(Signature) Donald D. Vaughan

Box 825, Great Bend, Kansas

(Address)

SUBSCRIBED AND SWORN to before me this 3rd day of May, 19 65

My commission expires Jan. 24, 1968

Dorothy Tully
Notary Public.

Petroleum Repressuring, Inc.
710 Union Building
Wichita, Kansas

Re: McCune #1
SW-SW-NW Sec. 10,
T-25-S, R-11-W,
Stafford County, Kansas

Gentlemen:

Contained herein is my geological report of the above captioned well.

<u>Formation</u>	<u>Depth</u>	<u>Subsea Depth</u>
Topeka Limestone	2928	-1130
Heebner	3244	-1446
Toronto Limestone	3264	-1466
Douglas Shale	3274	-1476
Douglas Sandstone	3314	-1516
Brown Limestone	3407	-1609
Lansing Limestone	3435	-1637
Total Depth	3470	-1672


The only show of oil and/or gas encountered in the McCune #1 was in the Lansing Limestone from 3460' to 3470'. This zone was covered by drill-stem test #1, the results of which are given below:

DST #1 3460' - 3470' (Lansing)
Open 1½ hours
Recovered: 260' Gas
 40' oil-cut mud
Pressures: Initial Shut In - 105#/30"
 Final Shut In - 105#/30"

The bottom-hole pressures of the Lansing horizon, which produces in the Vogel Pool, are too low to be capable of producing without repressuring this zone.

It was recommended that the McCune #1 be abandoned as a dry hole at the total depth of 3470'.

Respectfully submitted,


Robert L. Jones-Geologist

WELL LOG

COMPANY Petroleum Repressuring, Inc.
 CONTRACTOR Vaughan Drilling, Inc.
 FARM #1 McCune
 LOCATION SW SW NW of sec. 10-25-11W
 Stafford County, Kansas
 ELEVATION 1798 K. B.
 SURFACE PIPE 8 5/8" set @ 229' with 225 sx posmix sunset.
 PRODUCTION D & A
 COMMENCED April 22, 1965
 COMPLETED April 29, 1965

<u>FORMATION</u>	<u>DEPTH</u>
Sandstone	135
Red Bed	229
Blue Clay & Sandstone	280
Shale & Shells	1400
Limestone & Shale	3015
Limestone	3030
Limestone & Shale	3470
Rotary Total Depth	3470

RECEIVED
 STATE CORPORATION COMMISSION

MAY 4 1965

CONSERVATION DIVISION
 Wichita, Kansas

FORMATION TOPS

Topeka	2930 (-1132)
Heebner	3244 (-1446)
Lansing	3435 (-1637)
Rotary total depth	3470 (-1672)

A F F I D A V I T

STATE OF KANSAS., COUNTY OF BARTON, SS:

I, Donald D. Vaughan, of the VAUGHAN DRILLING, INC., being first duly sworn on oath, state that I have knowledge of the facts, statements and matters herein contained and that the same are true and correct.

Donald D. Vaughan
 Donald D. Vaughan

Subscribed and sworn to before me this 3rd day of May, 1965.

My commission expires: n Jan. 24, 1968

Dorothy Tully
 Dorothy Tully, Notary Public