

STATE OF KANSAS
STATE CORPORATION COMMISSION

WELL PLUGGING RECORD

Give All Information Completely
Make Required Affidavit
Mail or Deliver Report to:
Conservation Division
State Corporation Commission
800 Bitting Building
Wichita, Kansas

Stafford County: Sec. 15 Twp. 25 Rge. 11 (E) 11 (W)

Location as "NE/CNW/SW" or footage from lines SW SE NW

Lease Owner Speer Drilling Company

Lease Name Waters Well No. 1

Office Address Petroleum Bldg., Wichita, Kansas

Character of Well (completed as Oil, Gas or Dry Hole) Dry Hole

Date well completed 5-5-51 19

Application for plugging filed 5-5-51 19

Application for plugging approved 5-5-51 19


Plugging commenced 5-5-51 19

Plugging completed 5-5-51 19

Reason for abandonment of well or producing formation Dry Hole

If a producing well is abandoned, date of last production 19

Was permission obtained from the Conservation Division or its agents before plugging was commenced? yes

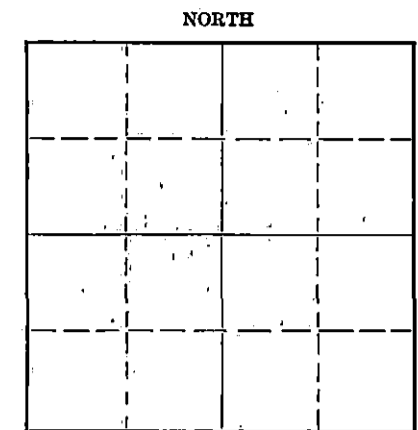

Locate well correctly on above Section Plat.

Name of Conservation Agent who supervised plugging of this well C. D. Stough

Producing formation Depth to top Bottom Total Depth of Well 3942 Feet

Show depth and thickness of all water, oil and gas formations.

OIL, GAS OR WATER RECORDS

CASING RECORD

Formation	Content	From	To	Size 5/8"	Put In 206'	Pulled Out None

Describe in detail the manner in which the well was plugged, indicating where the mud fluid was placed and the method or methods used in introducing it into the hole. If cement or other plugs were used, state the character of same and depth placed, from feet to feet for each plug set.

Bottom plug at 208', cemented with 15 sacks cement, filled hole with heavy mud. Set top plug at 30', cemented with 10 sacks cement.

(If additional description is necessary, use BACK of this sheet)

Correspondence regarding this well should be addressed to: Speer Drilling Company
Address: Petroleum Building, Wichita, Kansas

STATE OF Kansas, COUNTY OF Sedgwick, ss.
C. L. Gabbert (employee of owner) or (owner or operator) of the above-described well,

being first duly sworn on oath, says: That I have knowledge of the facts, statements, and matters herein contained and the log of the above-described well as filed and that the same are true and correct. So help me God.

(Signature) [Handwritten Signature] Petroleum Bldg., Wichita, Kansas (Address)

SUBSCRIBED AND SWORN to before me this 22nd day of May 1951

My commission expires October 27, 1954

RECEIVED Notary Public. STATE CORPORATION COMMISSION

PLUGGING FILE SEC 15 T 25 R 11 W BOOK PAGE 81 LINE 3

MAY 23 1951 CONSERVATION DIVISION Wichita, Kansas

Gabbert-Jones Drilling Company
 Wichita, Kansas
 Drillers Well Log

Waters #1
 SW SE NW4, Sec. 15-25-11W
 Stafford County, Kansas
 Commenced 4-17-51
 Completed 5-5-51

Depth		Formation	Remarks
From	To		
0	40	Surface sand	
40	120	Sand & gravel	
120	160	Red bed	
160	200	Red bed & shale	Ran 206' of 8 5/8" casing, cemented w/175 sacks cement.
200	600	Red bed	
600	865	Shale & shells	
865	1130	Shale, salt & shells	
1130	1230	Shale, salt & shells	
1230	1375	Anhydrite & shale	
1375	1575	Shale & lime	
1575	1895	Lime	
1895	2070	Lime & sand	
2070	2110	Lime & shale	
2110	2165	Lime	
2165	2190	Lime & shale	
2190	2245	Shale	
2245	2265	Lime	
2265	2535	Lime & shale	
2535	2725	Shale	
2725	3085	Lime & shale	
3085	3300	Lime	
3300	3355	Shale and salt lime	
3355	3375	Shaley sand	
3375	3444	Lime	
3444	3473	Shale & lime	
3473	3603	Lime	
3603	3650	Lime cherty	
3650	3690	Lime & chert	
3690	3762	Lime	
3762	3820	Lime & chert	
3820	3907	Lime & shale	
3907	3913	Cherty lime & shale	
3913	3942	Lime	
3942	TD	Dry	Plugged, bottom plug at 208' w/15 sacks cement. Top plug at 30' w/10 sacks cement.

RECEIVED
 CORPORATION COMMISSION
 MAY 23 1951
 CONSERVATION DIVISION
 Wichita, Kansas

Executed, This 14th day of May, 1951

STATE OF KANSAS)

COUNTY OF SEDGWICK)

ss Acknowledgment for Individual

C. H. Gabbert

Before me, the undersigned, a Notary Public, within and for said county and state, on this 14th day of May, 1951, personally appeared C. H. Gabbert to me personally known to be the identical person who executed the within and foregoing instrument and acknowledged to me that he executed the same as his free and voluntary act and deed for the uses and purposes therein set forth.

IN WITNESS WHEREOF, I have hereunto set my hand and official seal the day and year last above written.

My commission expires October 27, 1954

Ernest E. Hall
 Notary Public

FILE SEC 15 T 25 R 11W
 BOOK PAGE 81 LINE 3