


WELL PLUGGING RECORD

Give All Information Completely
Make Required Affidavit
Mail or Deliver Report to:
Conservation Division
State Corporation Commission
211 No. Broadway
Wichita, Kansas

Stafford County. Sec. 15 Twp. 25 Rge. 11 (E) (W) -
Location as "NE/CNW/SW" or footage from lines NW NW SE
Lease Owner H. C. Zink
Lease Name Patler Well No. 1
Office Address Juron, Kansas
Character of Well (completed as Oil, Gas or Dry Hole) Dry Hole
Date well completed 1-2-1964 19
Application for plugging filed 19
Application for plugging approved 19
Plugging commenced March 7-1964 19
Plugging completed: March 11-1964 19
Reason for abandonment of well or producing formation Dry

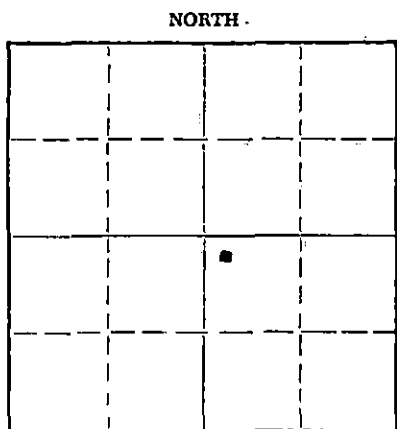

Locate well correctly on above
Section Plat

If a producing well is abandoned, date of last production 19
Was permission obtained from the Conservation Division or its agents before plugging was commenced? yes
Name of Conservation Agent who supervised plugging of this well Archie Elving
Producing formation _____ Depth to top 3482 Bottom 3486 Total Depth of Well 3924 Feet
Show depth and thickness of all water, oil and gas formations.

OIL, GAS OR WATER RECORDS

CASING RECORD

FORMATION	CONTENT	FROM	TO	SIZE	PUT IN	PULLED OUT
				8 5/8"	252	
				5 1/2"	3914	3018

Describe in detail the manner in which the well was plugged, indicating where the mud fluid was placed and the method or methods used in introducing it into the hole. If cement or other plugs were used, state the character of same and depth placed, from _____ feet to _____ feet for each plug set.

Plugged back to 3470' - Run 5 sacks cement in dump trailer from 3470 to 3440
Mud from reserve pit, from 3440' to 250'
Rock bridge 250' to 240'
Twenty five (25) sacks cement from 240' to 170'
Mud from pit 170' to 30'
Ten (10) sacks cement from 30' to base of cellar

RECEIVED
STATE CORPORATION COMMISSION

3-23-64 MAR 23 1964

CONSERVATION DIVISION
Wichita, Kansas

(If additional description necessary, use BACK of this sheet)
Name of Plugging Contractor Glen Smith Pipe Pulling
Address 204 E 6th Ellsworth Ave.

STATE OF Kansas, COUNTY OF Stafford, ss.
_____, (employee of owner) or (owner or operator) of the above-described well, being first duly sworn on oath, says: That I have knowledge of the facts, statements, and matters herein contained and the log of the above-described well as filed and that the same are true and correct. So help me God.

(Signature) H. C. Zink
Juron, Kansas
(Address)

SUBSCRIBED AND SWORN to before me this 19 day of March, 1964

My commission expires Aug 4, 1966

Notary Public.


KANSAS GEOLOGICAL SOCIETY
 KANSAS WELL LOG BUREAU - KANSAS WELL SAMPLE BUREAU
 KANSAS GEOLOGICAL SOCIETY BUILDING
 508 EAST MURDOCK - WICHITA, KANSAS

COMPANY H-30, Inc., et al
 FARM Potter NO. 1

SEC. 15 T. 25S R. 11W
 LOC. NW NW SE

TOTAL DEPTH 3,924'
 COMM. 12-16-63 COMP. 1-2-64
 SHOT OR TREATED
 CONTRACTOR H-30, Inc.
 ISSUED

COUNTY Stafford
 KANSAS

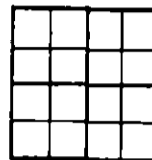

CASING
 20 10
 15 5/8" 252' cem w/225 sx
 12 6
 13 1/2" 3,914' cem w/125 sx

1795 GR
 ELEVATION 1797 DF
 1800 KB
 PRODUCTION

FIGURES INDICATE BOTTOM OF FORMATIONS

Sand and clay	60
Sand	155
Shale & red bed	252
Red Bed & shale	533
Anhydrite	558
Shale & shells	1480
Lime & Shale	2375
Shale & Lime	3155
Lime & Shale	3235
Lime	3370
Lime & Shale	3470
Lime	3774
Shale & Lime	3820
Lime	3865
Shale	3914
Cherty Lime	3924
Rotary Total Depth	3924

*Perf. 3482-89
 Perf. 3531-37*

Sample Tops

Topeka	2670	- 870
Heebner	3264	-1464
Brown Lime	3424	-1624
Lansing	3448	-1648
Base Kansas City	3746	-1946
Kinderhook Lime	3810	-2010
Kinderhook Shale	3826	-2026
Viola	3912	-2112
Rotary T. D.	3924	-2124

RECEIVED
 STATE CORPORATION COMMISSION

MAR 23 1964

CONSERVATION DIVISION
 Wichita, Kansas

I hereby certify that the above and foregoing is a true and correct log of the above described well as shown by the drilling reports.

H-30, INC.

By Merle Britton

State of Kansas)
 Sedgwick County) SS:

Subscribed and sworn to before me, a Notary Public in and for said county and state, this 13th day of January, 1964.

Geraldine Hays
 Geraldine Hays, Notary Public

My Commission Expires:
 December 3, 1964.

Ralph Glenn
Phone JO 4-43007

INVOICE

Glenn & Smith Pipe Pulling Co.

R. E. Smith
Phone JO 4-3134

Box 156
ELLINWOOD, KANSAS

Date 3/11/64

Sold To: G. E. Zink

Invoice No. 9

Well No. 1

Sec. 15-25-11

Lease Potter

3/7/64	Rigging up. Run plug to 3470'. Run 5 sacks of cement 3470' to 3440'. Working 5 1/2" pipe.	7 hrs.	\$ 49.00
3/9/64	Shot 5 1/2" pipe at 3227', 3104', 3014' & started pipe.	7 hrs.	49.00
3/10/64	Pulling pipe. Mudded from 3440' to 250'. Rock bridge 250' to 240'. Run 5 sacks of cement from 240' to 230'.	2 hrs.	14.00
3/11/64	Bailed out water & run 20 sacks of cement from 230' to 170'. Mudded from 170' to 30'. Run 10 sacks of cement from 30' to base of cellar.	3 hrs.	21.00

19 hrs. @ \$ 7.00 per hr.	\$ 133.00
3018' 5 1/2" @ .20 per ft.	603.60
3 shots @ 10.00 per shot	30.00
40 sacks cement @ \$1.50 per sack	61.50
Tax 1.50	

\$ 828.10

RECEIVED
STATE CORPORATION COMMISSION
MAR 23 1964
CONSERVATION DIVISION
Wichita, Kansas

Permit No. 396
State Plugger: Archie Elving

THANK YOU