

STATE OF KANSAS
STATE CORPORATION COMMISSION

WELL PLUGGING RECORD

Give All Information Completely
Make Required Affidavit
Mail or Deliver Report to:
Conservation Division
State Corporation Commission
800 Bitting Building
Wichita, Kansas

Stafford County, Sec. 15 Twp. 25 Rge. 11^W (E) (W)

Location as "NE/CNW $\frac{1}{4}$ SW $\frac{1}{4}$ " or footage from lines SW SE SW

Lease Owner The Derby Oil Company

Lease Name Tarrant Well No. 2

Office Address 420 W. Douglas - Wichita, Kansas

Character of Well (completed as Oil, Gas or Dry Hole) Oil

Date well completed October 8, 1952

Application for plugging filed June 29, 1953

Application for plugging approved July 1, 1953


Plugging commenced July 8, 1953

Plugging completed July 16, 1953

Reason for abandonment of well or producing formation Well has reached economic limit.

If a producing well is abandoned, date of last production June 20, 1953

Was permission obtained from the Conservation Division or its agents before plugging was commenced? Yes

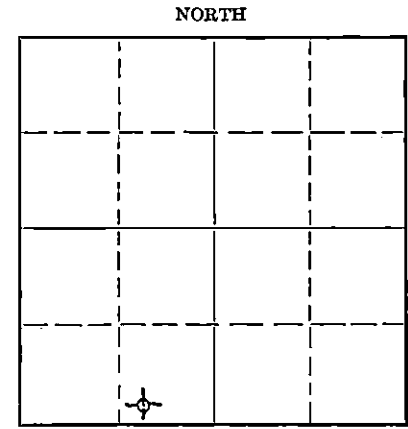

Locate well correctly on above Section Plat

Name of Conservation Agent who supervised plugging of this well Merle Rives

Producing formation Viola Depth to top 3948 Bottom --- Total Depth of Well 3953 Feet

Show depth and thickness of all water, oil and gas formations.

OIL, GAS OR WATER RECORDS

CASING RECORD

Formation	Content	From	To	Size	Put In	Pulled Out
				8 5/8"	287'	None
Viola Lime	Oil & water	3948	3953	5 1/2"	3947'	2185'

Describe in detail the manner in which the well was plugged, indicating where the mud fluid was placed and the method or methods used in introducing it into the hole. If cement or other plugs were used, state the character of same and depth placed, from _____ feet to _____ feet for each plug set.

Sanded hole from 3947' to 3935' and ran 5 sacks of cement. Bailed fluid to 287' and mudded hole to 287'. Set 10' rock bridge and ran 15 sax of cement. Mudded hole to 45', set 10' rock bridge and ran 10 sacks of cement. Plugging completed.

RECEIVED
STATE CORPORATION COMMISSION
JUL 25 1953
CONSERVATION DIVISION
Wichita, Kansas

(If additional description is necessary, use BACK of this sheet)

Name of Plugging Contractor West Supply Company
Address Chase, Kansas

STATE OF KANSAS, COUNTY OF SEDGWICK, ss.
F. W. Heiser (employee of owner) or (owner/operator)

being first duly sworn on oath, says: That I have knowledge of the facts, statements, and matters herein contained and the log of the above-described well as filed and that the same are true and correct. So help me God.

(Signature) *F. W. Heiser*

Box 1030, Wichita, Kansas
(Address)

SUBSCRIBED AND SWORN TO before me this 24th day of July, 1953

W. Wilson
Notary Public.

My commission expires August 24, 1953

PLUGGING
FILE SEC 15 T 25 R 11W
BOOK PAGE 11 LINE 31

COMPANY: Derby Oil Company
 CONTRACTOR: Mallard Drilling Company
 FARM: Tarrant #2
 LOCATION: SW SE SW 15-25-11W.
 Stafford County, Kansas.
 COMMENCED: September 15, 1952.
 COMPLETED: September 30, 1952.

0	-	190	Surface Sand
190	-	279	Red bed
279	-	935	Shale & shells
935	-	1500	Shale & Lime
1500	-	1635	Lime & sand
1635	-	2145	Lime
2145	-	2780	Lime & shale
2780	-	2910	Lime
2910	-	2990	Lime & shale
2990	-	3210	Lime
3210	-	3415	Shale & Lime
3415	-	3880	Lime
3880	-	3930	Shale
3930	-	3953	Lime
		3953	Total depth - rotary

Set 282' of 8 5/8" surface pipe - cemented with 200 sax plasmix.

Set 5 1/2" casing at 3949'

Measurements from kelly bushing.

C E R T I F I C A T E

I, C. C. Nelson, do hereby certify that the above and foregoing is a true and correct copy of the driller's log, on the above described well, as shown by the files of the Mallard Drilling Company.

C. C. Nelson

Subscribed and sworn to before me, a Notary Public within and for Sedgwick County, Kansas - this 7th day of October, 1952.

Harwell Wright
 Notary Public

My commission expires: 12-1-52.

RECEIVED
 STATE CORPORATION COMMISSION

JUL 25 1953

CONSERVATION DIVISION
 Wichita, Kansas

PLUGGING
 FILE SEC 15 T 215 R 11W
 BOOK PAGE 11 LINE 31