

STATE OF KANSAS
STATE CORPORATION COMMISSION
Give All Information Completely
Make Required Affidavit
Mail or Deliver Report to:
Conservation Division
State Corporation Commission
211 No. Broadway
Wichita, Kansas

WELL PLUGGING RECORD

Stafford County, Sec. 23 Twp. 25 Rge. 13 (E) (W)

Location as "NE/CNW/SW" or footage from lines NW SE NW

Lease Owner N. Appleman Co.

Lease Name McCandless Well No. 2

Office Address 665 Fifth Ave. New York City, New York

Character of Well (completed as Oil, Gas or Dry Hole) Dry Hole

Date well completed 9-15 19 56

Application for plugging filed 9-15 19 56

Application for plugging approved 9-15 19 56


Plugging commenced 9-15 19 56

Plugging completed 9-15 19 56

Reason for abandonment of well or producing formation Dry Hole

If a producing well is abandoned, date of last production None 19

Was permission obtained from the Conservation Division or its agents before plugging was commenced? Yes

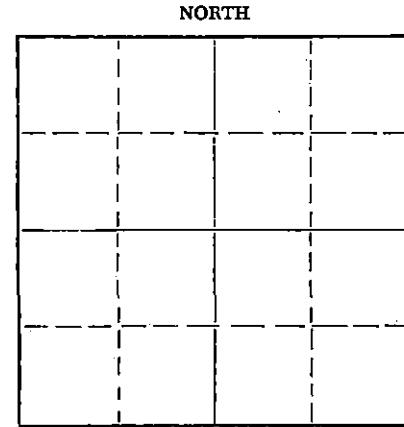

Locate well correctly on above Section Plat

Name of Conservation Agent who supervised plugging of this well R. M. Brundege, Box 283, Hoisington, Ks.

Producing formation Depth to top Bottom Total Depth of Well 4226 Feet

Show depth and thickness of all water, oil and gas formations.

OIL, GAS OR WATER RECORDS

CASING RECORD

FORMATION	CONTENT	FROM	TO	SIZE	PUT IN	PULLED OUT
				8 5/8	252.20	None

Describe in detail the manner in which the well was plugged, indicating where the mud fluid was placed and the method or methods used in introducing it into the hole. If cement or other plugs were used, state the character of same and depth placed, from feet to feet for each plug set.

Mudded to top. Set plug, added half sack of hulls, 20 sacks of cement. Added one-half sack of hulls, Set plug and cemented with 10 sacks of cement.

RECEIVED
STATE CORPORATION COMMISSION
NOV 20 1956
CONSERVATION DIVISION
WICHITA, KANSAS

(If additional description is necessary, use BACK of this sheet)

Name of Plugging Contractor Russell Breckenridge, Address Hoisington, Kansas.

STATE OF Kansas, COUNTY OF Sedgwick, ss. R.E. Welch (employee of owner) or (owner or operator)

of the above-described well, being first duly sworn on oath, says: That I have knowledge of the facts, statements, and matters herein contained and the log of the above-described well as filed and that the same are true and correct. So help me God.

(Signature) [Signature] 203 Rule Bldg. Wichita, Ks. (Address)

SUBSCRIBED AND SWORN TO before me this 19th day of November, 19 56

My commission expires June 12, 1959

Edith Erker Notary Public.

PLUGGING
FILE SEC 23 T 25 R 136
BOOK PAGE 117 LINE 25

WELL LOG.

N. APPLEMAN CO. 665 Fifth Ave. New York City:

ELEVATION: 1929 R.B.

CONTRACTOR: WELCH & OLSSON DRILLING CO. INC.

COMM. DRLG: 11-3-56

MCCANDLESS #2 ^{NW} SE NW of Sec. 23-25-13
Stafford County, Kansas.

COMPL. DRLG: 11-15-56

PRODUCTION: D & A.

CASING RECORD.

Set 252.20' of 8 5/8" with 200 sacks of cement.

(Figures indicated bottom of formations.)

<u>FORMATIONS:</u>	<u>DEPTHS.</u>
Sand:	190
Red Bed & Shale:	250
Shale:	753
Anhydrite:	767
Shale & Shells:	1775
Shale & Lime:	1880
Lime:	2035
Shale & Lime:	2355
Shale W/Lime Streaks:	2555
Shale & Shells:	2890
Shale & Lime:	3265
Lime:	3325
Lime & Shale:	3550
Shale & Lime:	3640
Lime:	4085
Chert & Lime:	4180
Lime:	4199
Sand:	4226 T.D.

STATE OF KANSAS,)
) SS:
SEDGWICK COUNTY,)

I hereby certify that the above is a true and correct copy of Drillers Log of well drilled in the NW SE NW of Section 23, Township 25, Range 13 West, Stafford County, Kansas.

RECEIVED
KANSAS CORPORATION COMMISSION
NOV 20 1956
CONSERVATION DIVISION
Wichita, Kansas

WELCH & OLSSON DRILLING COMPANY, INC.
BY [Signature]
R. E. WELCH

Subscribed and sworn to before me this 19th day of November, 1956.

[Signature]
Edith Erker, Notary Public.

My commission expires:
June 12, 1959

PLUGGING
FILE SEC 23 T. 25 R. 13W
BOOK PAGE 112 LINE 25