


STATE OF KANSAS
STATE CORPORATION COMMISSION

WELL PLUGGING RECORD

Give All Information Completely
Make Required Affidavit
Mail or Deliver Report to:
Conservation Division
State Corporation Commission
211 No. Broadway
Wichita, Kansas

Stafford County, Sec. 24 Twp. 25S Rge. 13W (E) (W)
Location as "NE/CNW%SW%" or footage from lines SE NE NW
Lease Owner Anschutz Drilling Co., Inc.
Lease Name Russell Well No. 1
Office Address 709 Union Natl. Bldg., Wichita, Kansas
Character of Well (completed as Oil, Gas or Dry Hole) Dry Hole
Date well completed February 20 1957
Application for plugging filed February 20 1957
Application for plugging approved February 20 1957
Plugging commenced February 20 1957
Plugging completed February 21 1957
Reason for abandonment of well or producing formation Dry Hole

NORTH

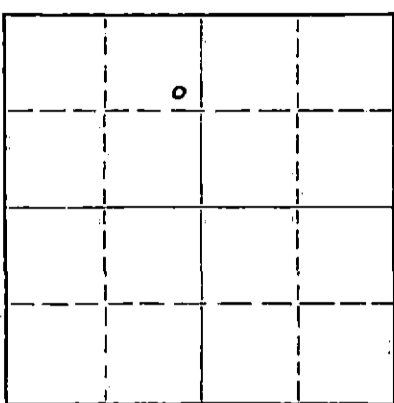

Locate well correctly on above
Section Plat

If a producing well is abandoned, date of last production _____ 19____
Was permission obtained from the Conservation Division or its agents before plugging was commenced? Yes

Name of Conservation Agent who supervised plugging of this well R. M. Brundege
Producing formation _____ Depth to top _____ Bottom _____ Total Depth of Well 4265 Feet
Show depth and thickness of all water, oil and gas formations.

OIL, GAS OR WATER RECORDS

CASING RECORD

FORMATION	CONTENT	FROM	TO	SIZE	PUT IN	PULLED OUT
				8-5/8"	250'	

Describe in detail the manner in which the well was plugged; indicating where the mud fluid was placed and the method or methods used in introducing it into the hole. If cement or other plugs were used, state the character of same and depth placed, from _____ feet to _____ feet for each plug set.

Drove bottom plug to 240'. Dumped 1/2 sack hulls. Cemented with 20 sacks cement through drill pipe. Filled hole to 20' with 1/2 sack hulls. Drove top plug to 20' and cemented with 4 sacks cement.


(If additional description is necessary, use BACK of this sheet)

Name of Plugging Contractor Anschutz Drilling Co., Inc.
Address 709 Union Natl. Bldg., Wichita, Kansas

STATE OF Kansas, COUNTY OF Sedgwick, ss.
Shirley Salley (employee of owner) or (owner or operator) of the above-described well, being first duly sworn on oath, says: That I have knowledge of the facts, statements, and matters herein contained and the log of the above-described well as filed and that the same are true and correct. So help me God.

(Signature) Shirley Salley Shirley Salley
709 Union Natl. Bldg., Wichita, Kansas
(Address)

SUBSCRIBED AND SWORN to before me this 25th day of February, 1957
Kenneth R. Swenson
Kenneth R. Swenson Notary Public.

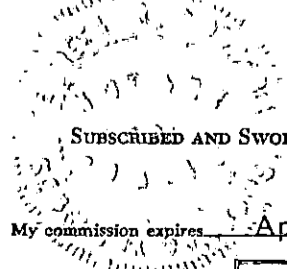

RECEIVED
STATE CORPORATION COMMISSION
PLUGGING
FILE SEC. 24 R. 13W 1957
BOOK PAGE 143
WICHITA, KANSAS
CONSERVATION DIVISION

DRILLERS' LOG

ANSCHUTZ DRILLING CO., INC.
 #1 RUSSELL
 SE NE NW Sec. 24-25S-13W
 Stafford County, Kansas

<u>FROM</u>	<u>TO</u>	
0	12	Soil
12	150	Sand
150	255	Shale and red bed
255	450	Shale and shells
450	757	Shale and red bed
757	790	Anhydrite
790	965	Sticky shale
965	1380	Shale
1380	1750	Shale and shells
1750	2325	Lime
2325	2660	Lime and shale
2660	2940	Shale and lime
2940	3755	Lime and shale
3755	3910	Lime
3910	3978	Lime and shale
3978	4050	Lime
4050	4058	Chert
4058	4105	Chert and lime
4105	4128	Lime and chert
4128	4176	Chert and sand
4176	4190	Sand
4190	4198	Shale
4198	4215	Shale and sand
4215	4226	Shale
4226	4253	Shale and lime
4253	4265	Arbuckle lime
	4265	Rotary Total Depth

COMMENCED: 2/7/57

COMPLETED: 2/20/57

CASING RECORD:
 Set 250' of 8-5/8" sur-
 face casing with 200
 sacks cement, 200# cal-
 cium chloride, 200# gel.

STATE OF KANSAS)
) SS
 COUNTY OF SEDGWICK)

I hereby affirm that the above and foregoing is a true and correct copy of the formations encountered on the #1 Russell, SE NE NW of Section 24-25S-13W, Stafford County, Kansas, as reflected by the daily drilling reports.

ANSCHUTZ DRILLING CO., INC.

By Shirley Salley
 Shirley Salley

Subscribed and sworn to before me this 25th day of February, 1957.

My Commission Expires: April 27, 1959

Kenneth R. Swenson
 Kenneth R. Swenson, Notary Public

RECEIVED
 STATE CORPORATION COMMISSION
PLUGGING
 FILE SEC 24 T 25 R 13W
 BOOK PAGE 143 LINE 23
 FEB 26 1957
 CONSERVATION DIVISION
 Wichita, Kansas