

STATE OF KANSAS  
STATE CORPORATION COMMISSION

WELL PLUGGING RECORD

Give All Information Completely  
Make Required Affidavit  
Mail or Deliver Report to  
Conservation Division  
State Corporation Comm.  
245 North Water  
Wichita, KS 67202

Edwards County, Sec. 2 Twp. 26S Rge. 16 E/W  
Location as "NE/CNW $\frac{1}{2}$ SW $\frac{1}{2}$ " or footage from lines  
C SW SW


Lease Owner Oil Properties Company, Inc.  
Lease Name Bryant "B" #1 Well No. 1  
Office Address P. O. Box 246, Augusta, Kansas 67010  
Character of Well (Completed as Oil, Gas or Dry Hole)  
Dry Hole

Date Well completed March 12, 1979 19  
Application for plugging filed March 12, 1979 19  
Application for plugging approved March 12, 1979 19  
Plugging commenced 1:00 PM, March 12, 1979 19  
Plugging completed 2:00 PM, March 12, 1979 19  
Reason for abandonment of well or producing formation  
Dry Hole

If a producing well is abandoned, date of last production 19

Was permission obtained from the Conservation Division or its agents before plugging was commenced? Yes

Name of Conservation Agent who supervised plugging of this well Bill Owen  
Producing formation \_\_\_\_\_ Depth to top \_\_\_\_\_ Bottom \_\_\_\_\_ Total Depth of Well 4430'  
Show depth and thickness of all water, oil and gas formations.

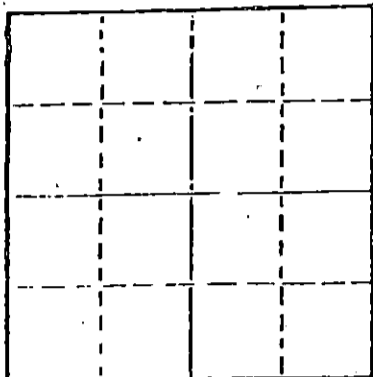

Locate well correctly on above Section List

OIL, GAS OR WATER RECORDS

CASING RECORD

FORMATION	CONTENT	FROM	TO	SIZE	PUT IN	PULLED OUT
				8 5/8"	139'	None

Describe in detail the manner in which the well was plugged, indicating where the mud fluid was placed and the method or methods used in introducing it into the hold. If cement or other plugs were used, state the character of same and depth placed, from \_\_\_\_\_ feet to \_\_\_\_\_ feet for each plug set.

Filled hole with heavy mud.  
Pumped through open ended Drill Pipe  
50 sacks at 730'. Solid bridge at  
40' with plug and 1/2 sack hulls and 12 sacks to  
surface. 3 sacks in rathole. Used 50/50 Pozmix.

(If additional description is necessary, use BACK of this sheet)

Name of Plugging Contractor STERLING DRILLING COMPANY, P. O. Box 129, Sterling, Kansas 67579

STATE OF KANSAS COUNTY OF RICE  
F. A. Wuellner (employee of owner) or (owner or operator)  
of the above-described well, being first duly sworn on oath, says: That I have knowledge of the facts, statements, and matters herein contained and the log of the above-described well as filed and that the same are true and correct. So help me God.

(Signature) F. A. Wuellner  
STERLING DRILLING COMPANY  
F. A. Wuellner, Secretary  
P. O. Box 129, Sterling, Kansas 67579  
(Address)

SUBSCRIBED AND SWORN TO before me this 15th day of March, 1979.



My commission expires \_\_\_\_\_

Charles M. Hall  
Charles M. Hall, Notary Public.

STERLING DRILLING COMPANY  
P. O. Box 129  
Sterling, Kansas 67579

WELL LOG ----- BRYANT "B" #1

Located: C SW SW, Section 2-26S-16W, Edwards County,  
Kansas

OWNER: Oil Properties Company, Inc.  
ROTARY DRILLING CONTRACTOR: Sterling Drilling Company

COMMENCED: March 6, 1979  
COMPLETED: March 12, 1979

TOTAL DEPTH: 4430'

<u>LOG</u>	<u>CASING RECORD</u>
0 - 228 Sand	Ran 10 joints used 2 1/4", 8 5/8" casing,
228 - 260 Shale	422.19' set at 439' K.B. with 325
260 - 290 Clay and Shale	sacks 60/40 Pozmix with 3% cc. Plug
290 - 437 Red Beds	down at 6:30 PM, 3-6-79, by Allied.
437 - 1035 Shale, Sand and Red Beds	
1035 - 1046 Anhydrite	
1046 - 1190 Shale	
1190 - 2140 Shale and Lime Stgs.	
2140 - 4400 Lime and Shale	
4400 - 4405 Chert and Sand	
4405 - 4430 Shale and Sand	Plugged.

RECEIVED  
APR - 15 1980  
Geological Division  
Kansas Geological Survey