

STATE OF KANSAS
STATE CORPORATION COMMISSION


WELL PLUGGING RECORD

15-09720554-0000

Give All Information Completely
Make Required Affidavit
Mail or Deliver Report to
Conservation Division
State Corporation Comm.
245 North Water
Wichita, KS 67202

EDWARDS County, Sec. 2 Twp. 26 Rge. 16 NW
Location as "NE/CNW $\frac{1}{4}$ /SW $\frac{1}{4}$ " or footage from lines
C SE NESW

Lease Owner OIL PROPERTIES CO, INC
Lease Name BRYANT Well No. 2-B
Office Address P. O. Box 335 ANDOVER, KS. 67002
Character of Well (Completed as Oil, Gas or Dry Hole)
DRY HOLE

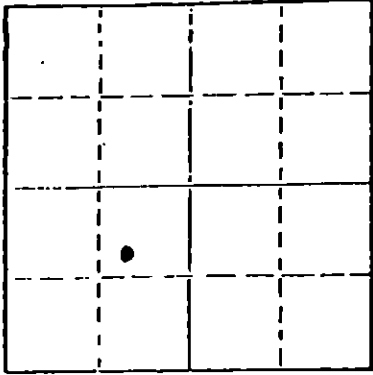

Locate well correctly on above
Section Plat

Date Well completed 9-18 1979
Application for plugging filed 9-18 1979
Application for plugging approved 9-18 1979
Plugging commenced 9-18 1979
Plugging completed 9-18 1979
Reason for abandonment of well or producing formation
CAVE IN BEFORE SURFACE CASING SET
If a producing well is abandoned, date of last production 19

Was permission obtained from the Conservation Division or
its agents before plugging was commenced? YES

Name of Conservation Agent who supervised plugging of this well WILLIAM OWENS
Producing formation _____ Depth to top _____ Bottom _____ Total Depth of Well 264'
Show depth and thickness of all water, oil and gas formations.

OIL, GAS OR WATER RECORDS

CASING RECORD

FORMATION	CONTENT	FROM	TO	SIZE	PUT IN	PULLED OUT

Describe in detail the manner in which the well was plugged, indicating where the mud fluid
was placed and the method or methods used in introducing it into the hold. If cement or other
plugs were used, state the character of same and depth placed, from 264 feet to
SURFACE feet for each plug set.

PRATT WELL SERVICE CROW RAN 120' OF 2" PLASTIC PIPE AND
HALLIBURTON CEMENTED WITH 200 SACKS OF 50-50 PORTLAND
CEMENT CIRCULATED AND CEMENTING COMPLETE AT 6:30 P.M.

RECEIVED
STATE CORPORATION COMMISSION
SEP 26 1979

(If additional description is necessary, use BACK of this sheet)
Name of Plugging Contractor HALLIBURTON & PRATT WELL SERVICE

STATE OF KANSAS COUNTY OF BUTLER, ss.
MICHAEL E. MOONEY (employee of owner) or (owner or operator)
of the above-described well, being first duly sworn on oath, says: That I have knowledge of
the facts, statements, and matters herein contained and the log of the above-described well
as filed and that the same are true and correct. So help me God.

(Signature) Michael E. Mooney VICE-PRES.
OIL PROPERTIES CO, INC / P.O. Box 335, ANDOVER
(Address)

SUBSCRIBED AND SWORN TO before me this 19th day of SEPTEMBER, 1979.

B.A. Traugott
Notary Public.

