


WELL PLUGGING RECORD

Give All Information Completely
Make Required Affidavit
Mail or Deliver Report to:
Conservation Division
State Corporation Commission
212 North Market, Insurance Bldg.
Wichita, Kansas

NORTH

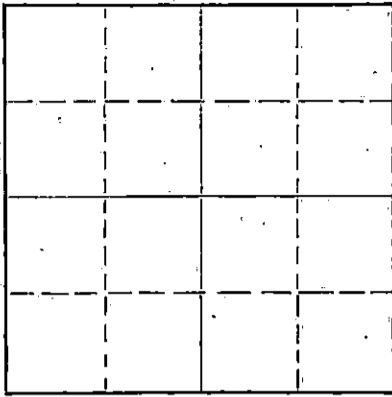

Locate well correctly on above
Section Plat

Reno County, Sec. 2 Twp. 26S Rge. (E) 9 (W)
Location as "NE/CNW/SW" or footage from lines S/2 SW/4 SE/4
Lease Owner Messman-Rinehart Oil Company
Lease Name Nunemaker "B" Well No. 1
Office Address 518 Petroleum Building, Wichita, Kansas
Character of Well (completed as Oil, Gas or Dry Hole) Dry Hole
Date well completed August 29 19 59
Application for plugging filed August 29 19 59
Application for plugging approved August 29 19 59
Plugging commenced August 29 19 59
Plugging completed August 29 19 59
Reason for abandonment of well or producing formation Dry

If a producing well is abandoned, date of last production 19
Was permission obtained from the Conservation Division or its agents before plugging was commenced? yes

Name of Conservation Agent who supervised plugging of this well Fred W. Hampel
Producing formation Depth to top Bottom Total Depth of Well 3935 Feet
Show depth and thickness of all water, oil and gas formations.

OIL, GAS OR WATER RECORDS

CASING RECORD

FORMATION	CONTENT	FROM	TO	SIZE	PUT IN	PULLED OUT
				8-5/8"	240'	none

Describe in detail the manner in which the well was plugged, indicating where the mud fluid was placed and the method or methods used in introducing it into the hole. If cement or other plugs were used, state the character of same and depth placed, from feet to feet for each plug set.

Filled with mud to 240 ft. Set plug at 240 ft. with 18 sx. cement and # sk. hulls. Filled with mud to 35 ft. Set plug at 35 ft. with 10 sx. cement. Mud to surface

RECEIVED
STATE CORPORATION COMMISSION
JAN 11 1960 1-11-60
CONSERVATION DIVISION
Wichita, Kansas

(If additional description is necessary, use BACK of this sheet)
Name of Plugging Contractor Messman-Rinehart Oil Company
Address 518 Petroleum Building, Wichita, Kansas

STATE OF Kansas COUNTY OF Sedgwick ss.
J. A. Gilliland (employee of owner) ~~owner~~ operator of the above-described well, being first duly sworn on oath, says: That I have knowledge of the facts, statements, and matters herein contained and the log of the above-described well as filed and that the same are true and correct. So help me God.
(Signature) J. A. Gilliland
518 Petroleum Building, Wichita, Kansas (Address)

SUBSCRIBED AND SWORN to before me this 7th day of October, 19 59
Barbara J. Scott, Notary Public.
My commission expires December 1, 1960

15-155-02029-0000

NO. 1 NUNEMAKER "8"

Well Record

Location: Ctr. S/2 SW/4 SE/4 Section 2-26S-9W
Reno County, Kansas

Commenced: August 18, 1959

Completed: August 29, 1959

Operator: Messman-Rinehart Oil Company
518 Petroleum Building
Wichita, Kansas

Elevation: 1685' K/B

Production: D & A

Contractor: Messman-Rinehart Oil Company
518 Petroleum Building
Wichita, Kansas

Casing Record: 8-5/8" @ 240' w/200 sk. com.

*** LOG ***

Sand and Clay	105
Red Bed	210
Plug and Cement	240
Shale & Shells	625
Shale	1235
Anhydrite	1270
Shale & Shells	1300
Lime and Shale	1535
Lime	1965
Lime and Shale	2625
Shale	2815
Lime and Shale	3220
Shale	3350
Lime	3545
Lime and Shale	3615
Lime	3785
Lime and Shale	3905
Shale	3911
Chert	3935 R.T.D.

Sample Tops:

1235' - Anhydrite (+450)
 3341' - Brown Lime (-1656)
 3371' - Lansing (-1686)
 3864' - Conglomerate (-2179)
 3911' - Mississippi (-2226)

1-11-60
RECEIVED
 STATE CORPORATION COMMISSION
 JAN 17 1960
 CONSERVATION DIVISION
 Wichita, Kansas

The undersigned, MESSMAN-RINEHART OIL COMPANY, hereby certifies that the above log is a true and correct log of the formation encountered in drilling the above well as reflected by the Daily Drilling Reports.

MESSMAN-RINEHART OIL COMPANY

By: J. A. Gilliland
J. A. Gilliland

Subscribed and sworn to before me this 24th day of September, 1959.

Barbara J. Scott
Barbara J. Scott, Notary Public

My Commission Expires: December 1, 1960